


T.4S R.4E W.M.

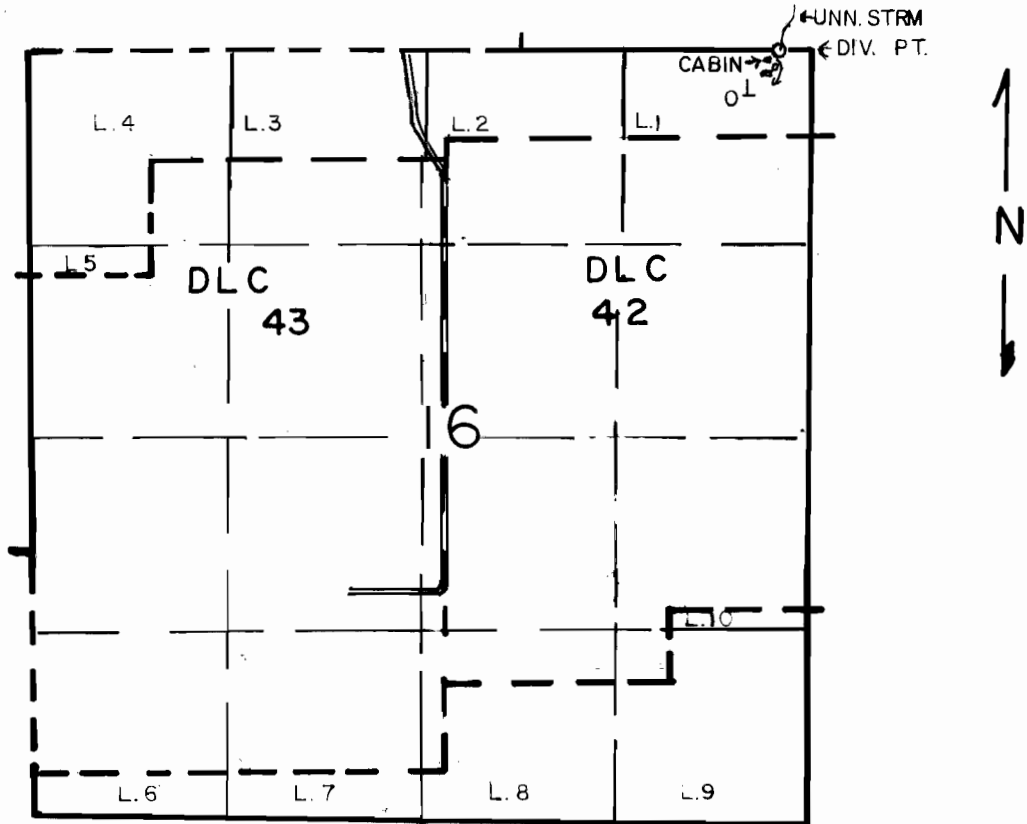

DIV. PT. LOCATED 200' W. FROM THE N.E. CORNER SECTION 16

SCALE: 1" = 1320'

FINAL PROOF SURVEY UNDER

Application No. 61289 Permit No. 47194
IN NAME OF

JAY VALENTINE GALLINGER

Surveyed JUNE 19 1987, by T.M. WARREN