


T. 40 S., R. 14 W., W. M.

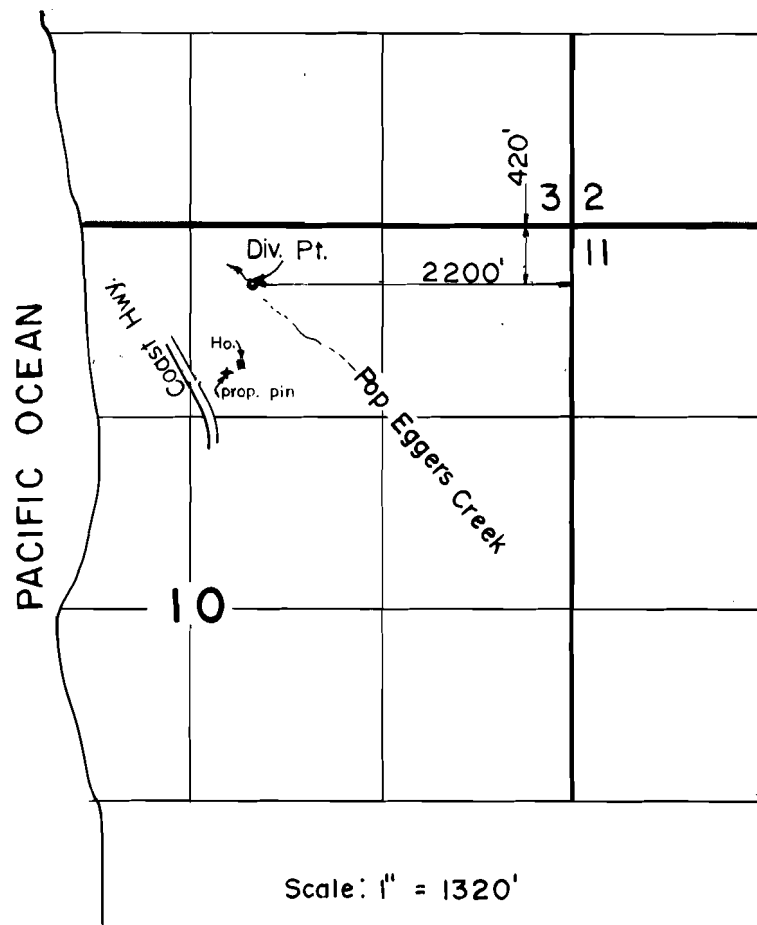

FINAL PROOF SURVEY
UNDER

Application No. 61602 Permit No. 45926
IN NAME OF

ELLIS H. NASON

Surveyed Sep. 1, 1988, by J. M. SCHMORDE