




T.28S., R.11W., W.M.

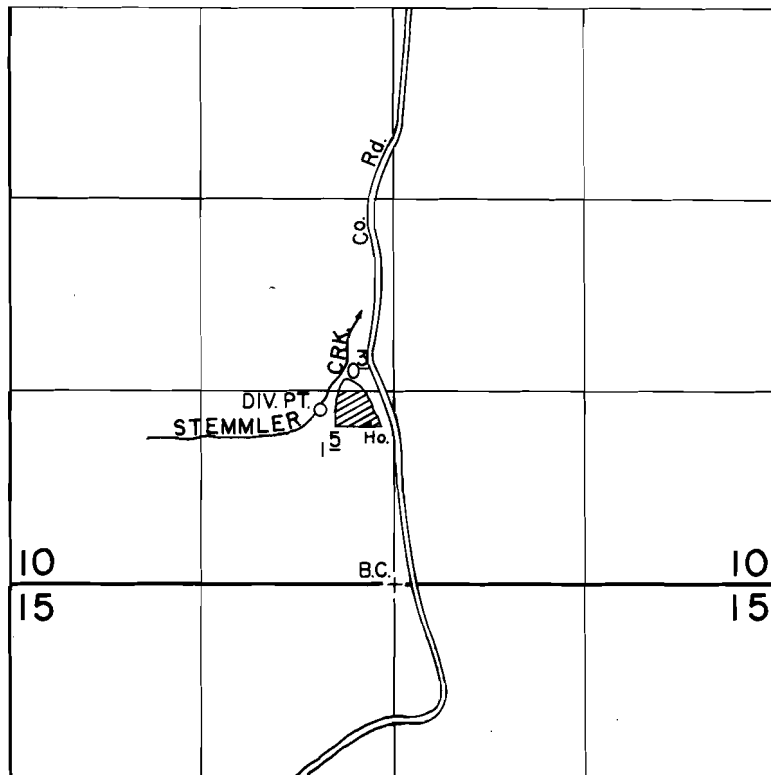

DIV. PT. LOC.: 1200' N. & 510' W. FROM THE S. 1/4 CORNER SECTION 10

SCALE: 1" = 1320'

FINAL PROOF SURVEY

UNDER

Application No. 61898..... Permit No. 46268.....
IN NAME OF

DORA CEMETERY ASSOCIATION.....

Surveyed SEPT. 17, 1988, by B. S. JAMES.....