


RECEIVED

JUL 27 1981

WATER RESOURCES DEPT
SALEM, OREGON

T27 S R14W

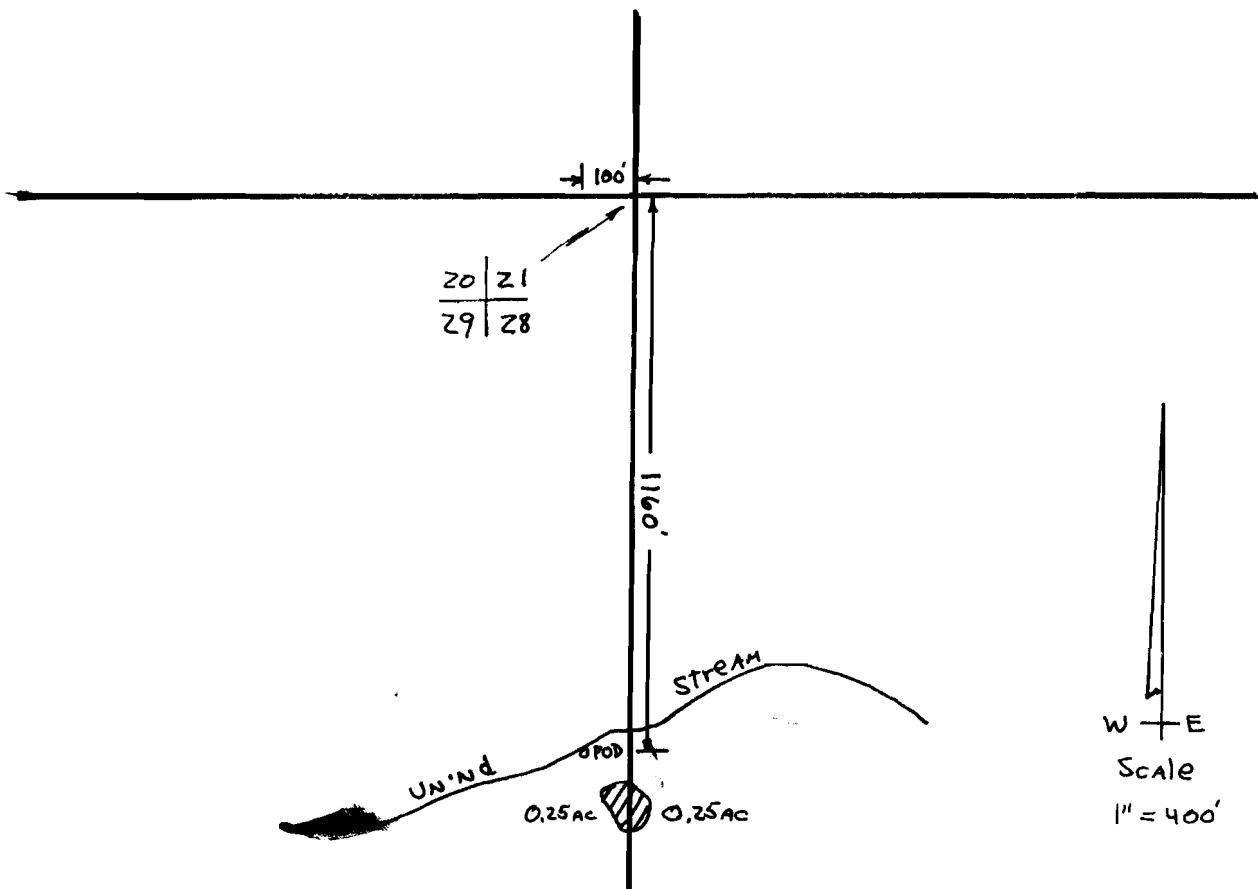

Application No. 61960
Permit No. 46283