


T.3S. R.IW. W.M

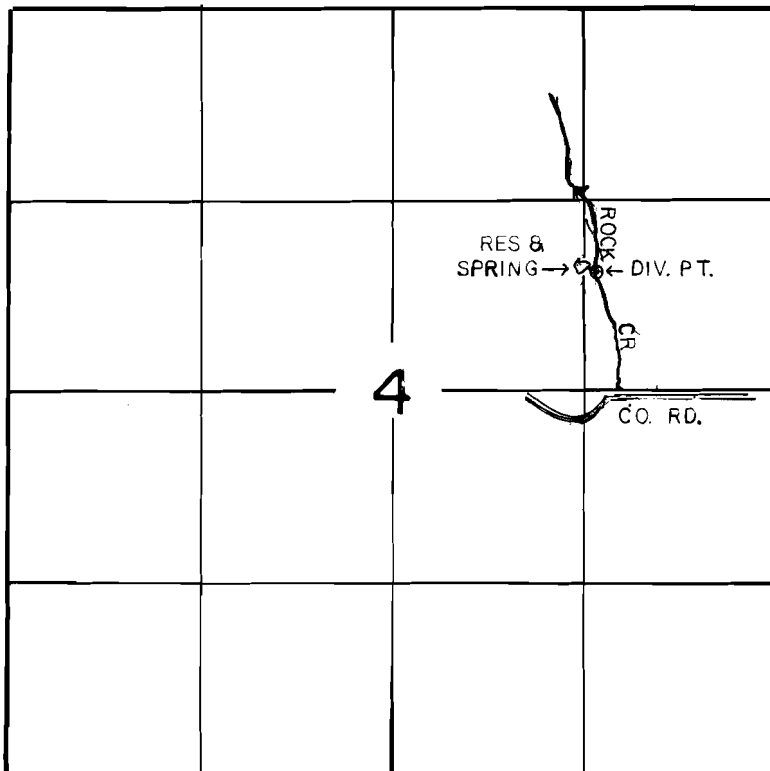

DIV. PT. LOC. 1800'S.AND 1200' W., SPRING LOC. 1750'S
AND 1250' W., BOTH FROM THE N.E. COR. SEC 4

SCALE: 1" = 1320'

FINAL PROOF SURVEY UNDER

R-62322 R-8436

Application No. 62323. Permit No. 46737....
IN NAME OF

.....RAYMOND R. NORGAARD.....

Surveyed AUG. 3..... 19.87., by T.M. WARREN.....