


T. 3S. R. 5E. W. M.

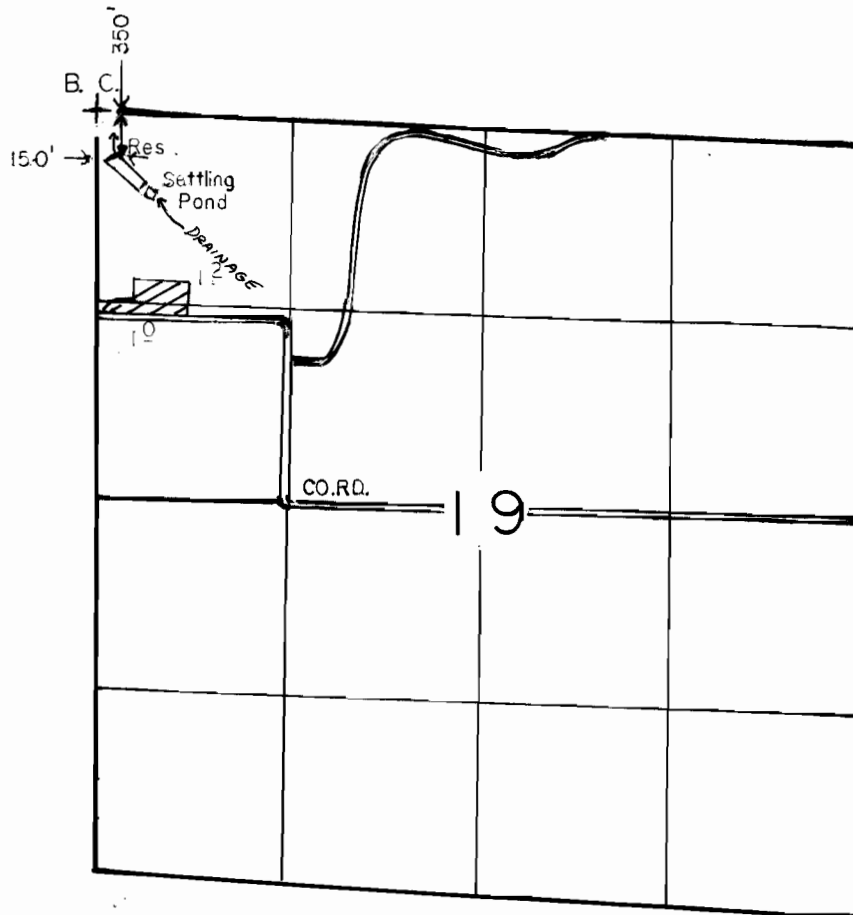

SCALE: 1" = 1320'

FINAL PROOF SURVEY

UNDER

R-62761

R-8313

Application No. ~~62762~~ Permit No. ~~46107~~.....
IN NAME OF

ELDRED M. GRIZZELL

Surveyed AUG. 27.... 1987., by J.M. WARREN.....