

RECEIVED

SEP 18 1981


WATER RESOURCES DEPT

62761

Application No. 62762

Permit No. R 8913 46107

T. 3S - R. 5E

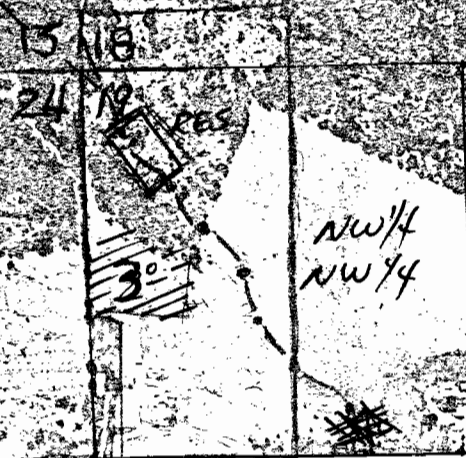

On Pt 350' S, 300' E from
NW cor. Sec 19.

SCALE 1/4" = 660'

LOCATION MAP
E.C. GRIZZELL