


Application No. ^{APPLICATION} # 63277
Permit No. 47273

6

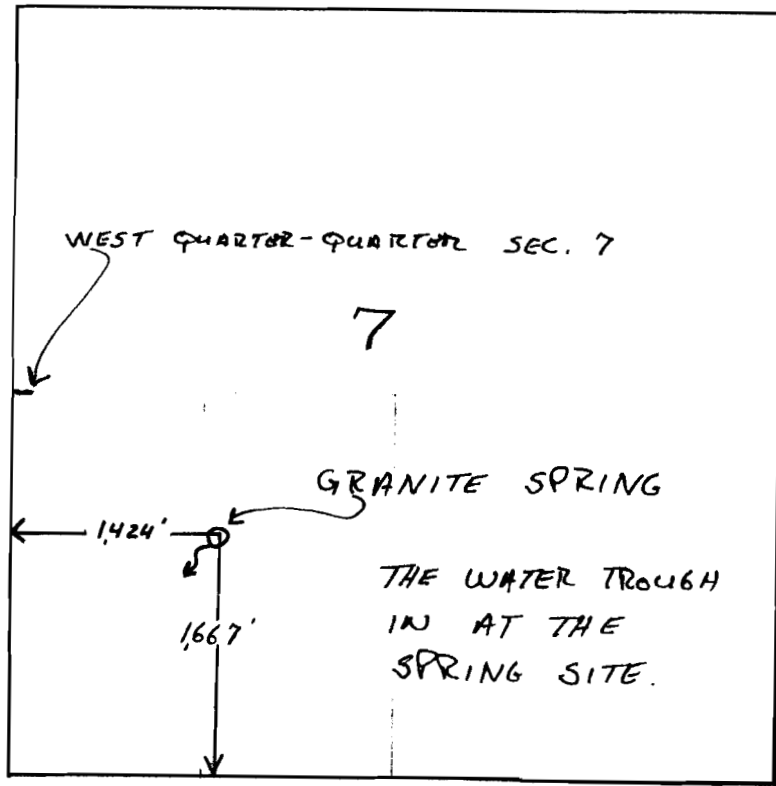

T 40 S R 32 E WBM

18

RECEIVED

NOV 15 1982

WATER RESOURCES DEPT.
SALEM, OREGON