


T.2S R.4E W.M.

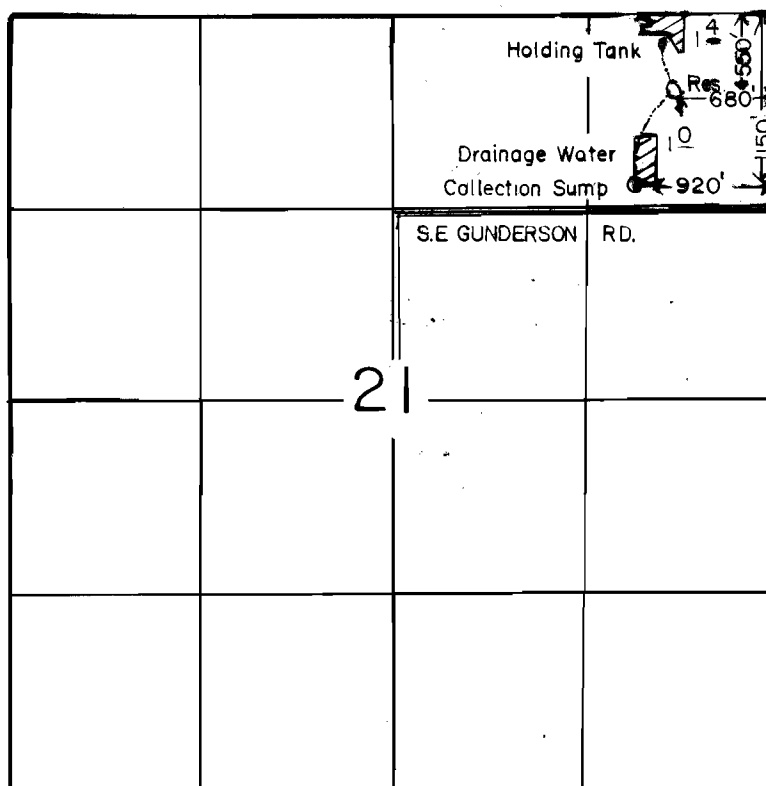

SCALE: 1"=1320'

FINAL PROOF SURVEY
UNDER

R-63531 R-8458
Application No. 63532 Permit No. 46828
IN NAME OF

HARRY L. BISBEE

Surveyed AUG 8 1987, by T. M. WARREN