


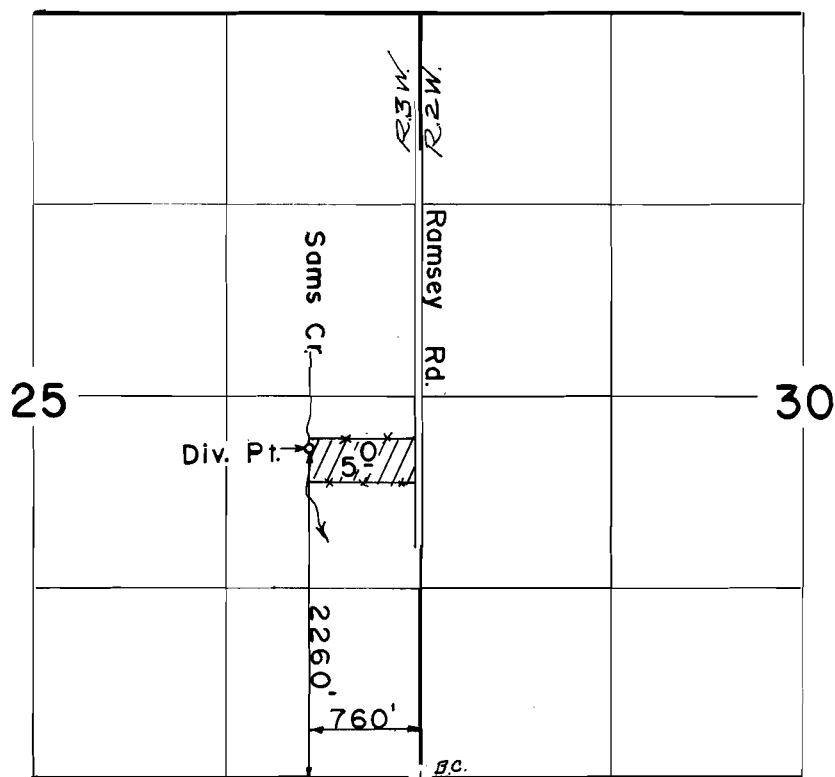

Scale: 1" = 1320'

FINAL PROOF SURVEY

UNDER

Application No. **63841**, Permit No. **47005**
IN NAME OF

.....WILLIAM R. HAUGHT.....

Surveyed JUN. 1 1987, by B. S. JAMES.