


T. 24 S., R. 4 W., W. M.

SECTIONS 5, 6, 7, & 8

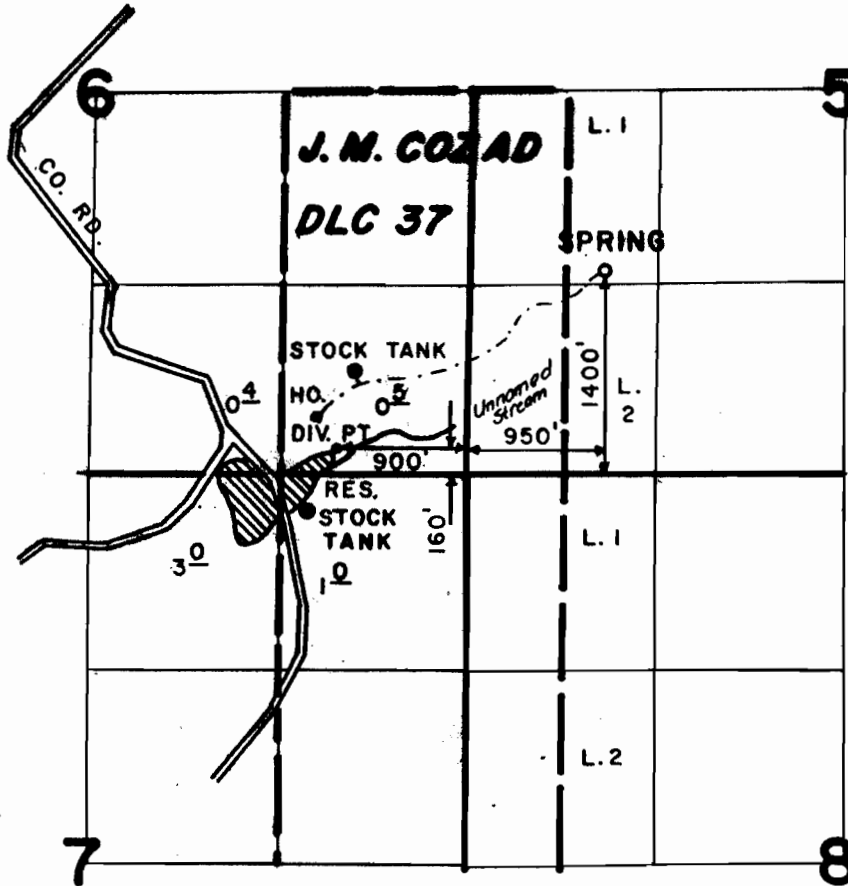

SCALE: 4" = 1 MILE

FINAL PROOF SURVEY
UNDER

R-63939 R-8535
Application No. 63940 Permit No. 47157
IN NAME OF

MORE MT. RANCH

Surveyed AUG 15 1988, by J. M. SCHMORDE