


T. 13 S., R. 9 E., W.M.  
SECTION 15

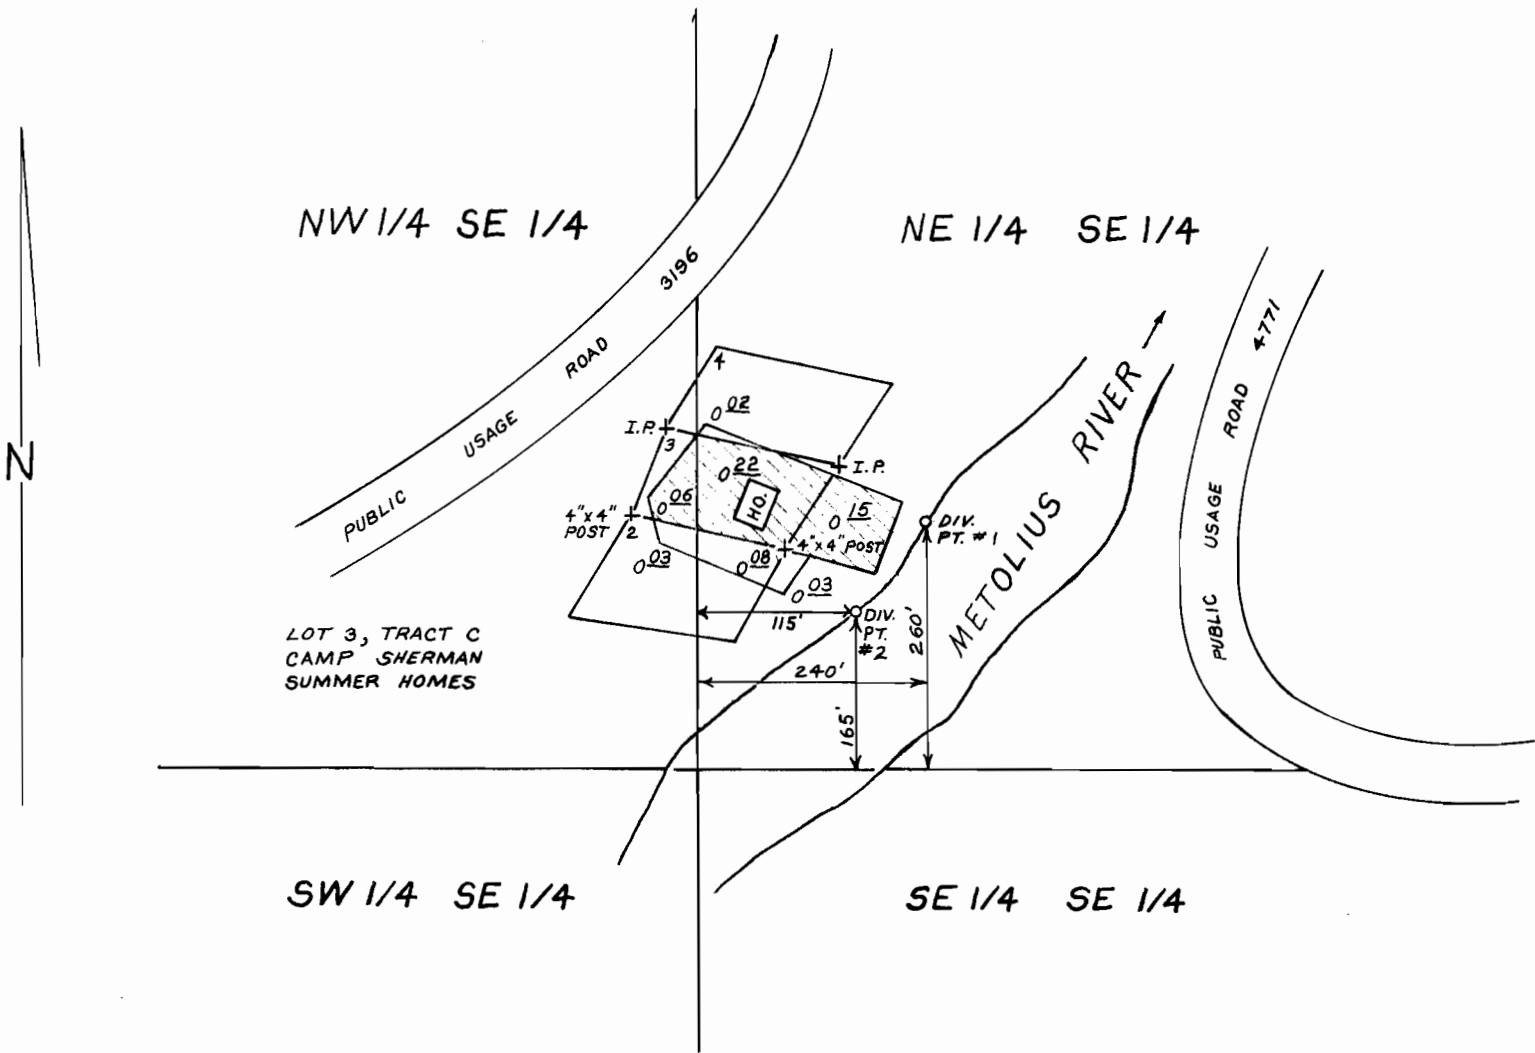

SCALE: 1" = 200'

FINAL PROOF SURVEY

UNDER

Application No. 65352 Permit No. 48269

IN NAME OF

ROBERT C. & JEAN S. MACDONALD

Surveyed MAY 1 1985, by TIM W. BURKS