


RECEIVED

MAR 20 1984

WATER RESOURCES DEPT.
SALEM, OREGON

T. 40 S., R. 4 W., W.M.

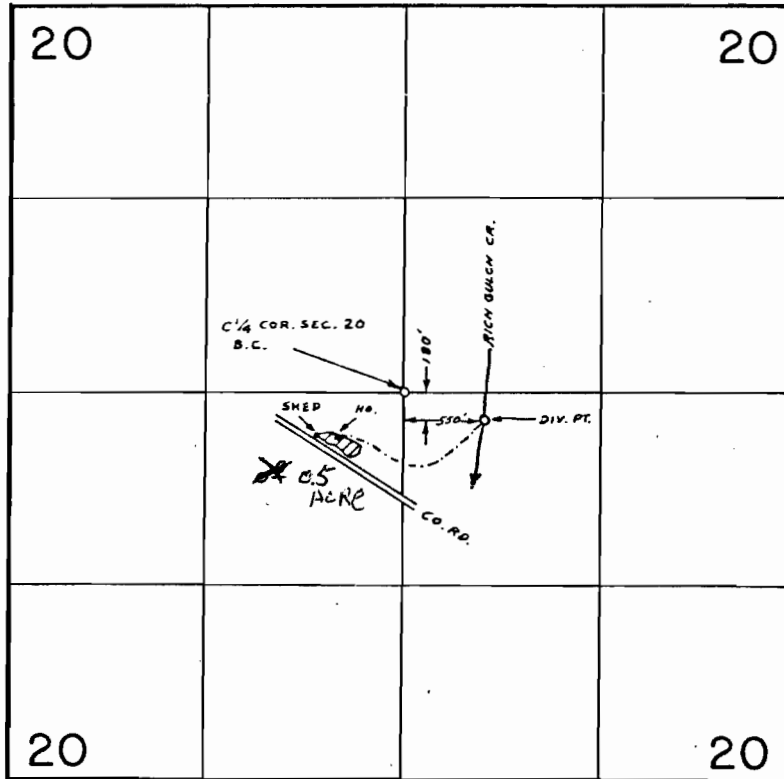

SCALE 4" = 1 MILE

RECEIVED

JAN 10 1984

WATER RESOURCES DEPT
SALEM, OREGON

RECEIVED

APR 16 1984

WATER RESOURCES DEPT
SALEM, OREGON

Application No. 67995
Permit No. 48458

SURVEY

UNDER

Application No. 67995 Permit No.

IN NAME OF

X CHARLES B. / Jill M. McClure

Surveyed JUL. 6 1978 by B. SUND