




T. 25 S., R. 11 W., W.M.

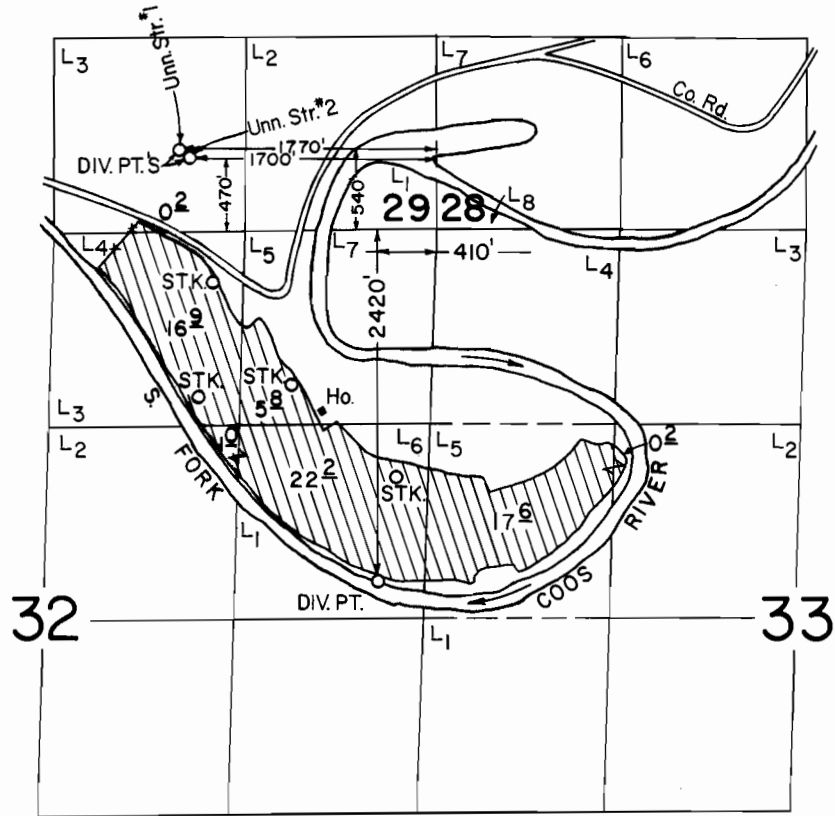

SCALE: 1" = 1320'

**FINAL PROOF SURVEY**  
UNDER

Application No. 68072.. Permit No. 48485.....  
IN NAME OF

WILLIAM D. HUNTER

Surveyed SEPT. 20 1988, by B. W. BISHOP.....