


T. 26S., R. 6W., W.M.

SEC. 27

NW1/4 SE1/4

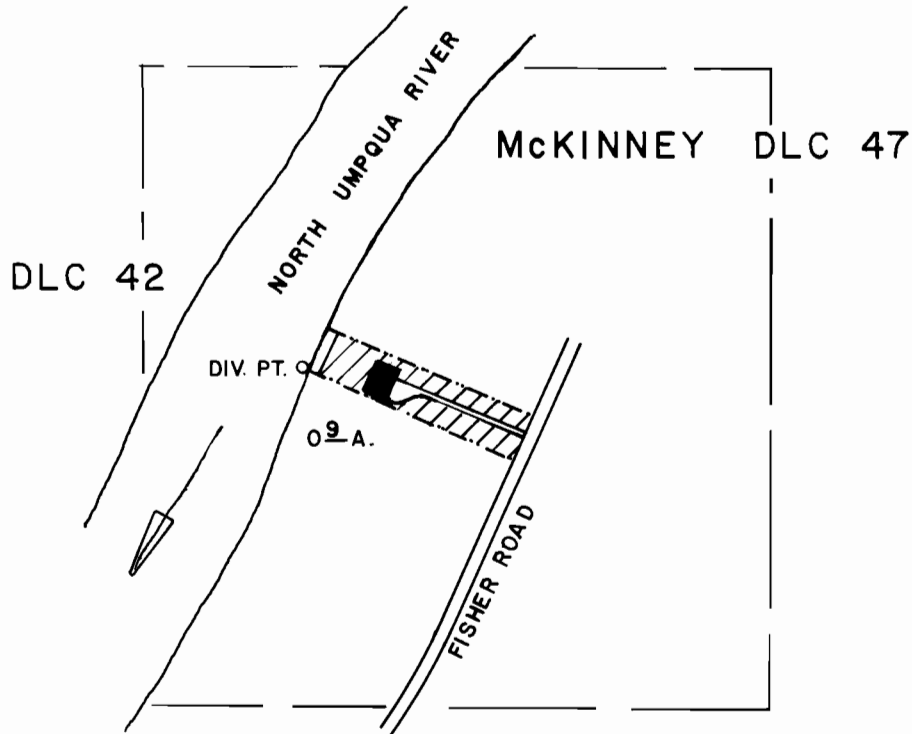

DIV. LOCATED 2010' N. & 350' E. OF S. 1/4 COR. SECTION 27.

SCALE: 1" = 400'



### FINAL PROOF SURVEY

UNDER

Application No. 68106 Permit No. 48551  
IN NAME OF

WILLIAMS, BEN H.

Surveyed OCT. 3 1985, by J.M. SCHMORDE