


T2S, R1&2E, WM

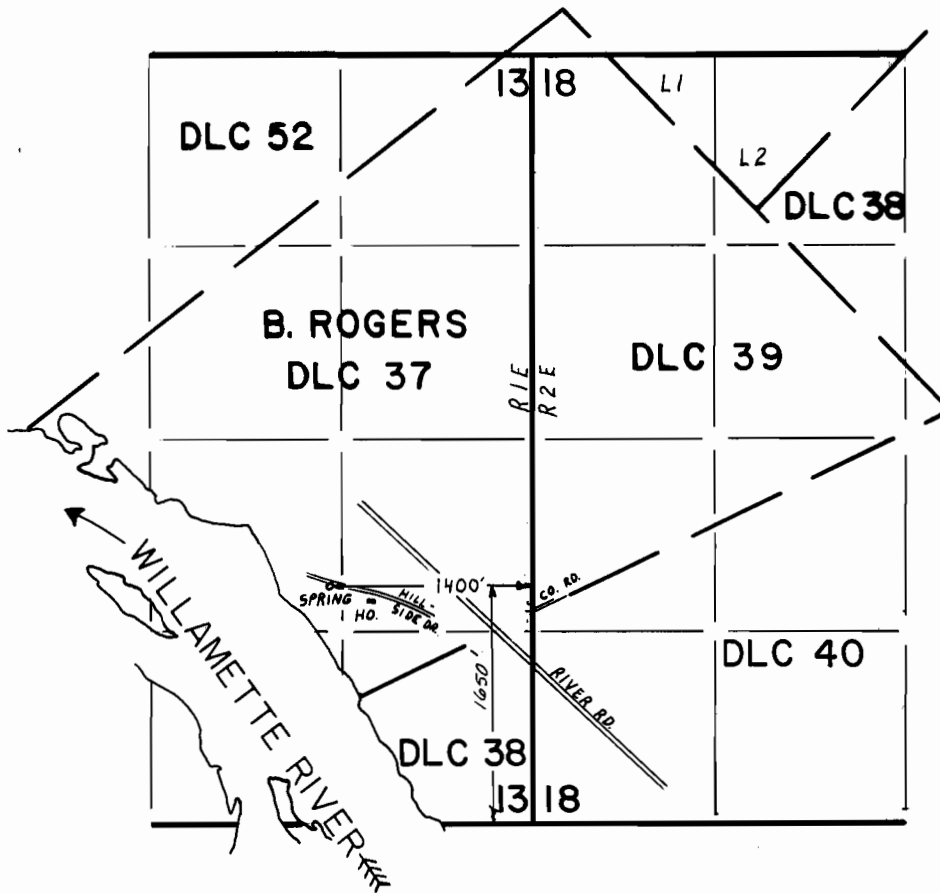

FINAL PROOF SURVEY UNDER

Application No. 68150 Permit No. 48761
IN NAME OF

STEPHEN'S COLLEGE

Surveyed AUG. 31. 1987., by T.M. WARREN.....