




T.25 & 26S.,R.11W.,WM.

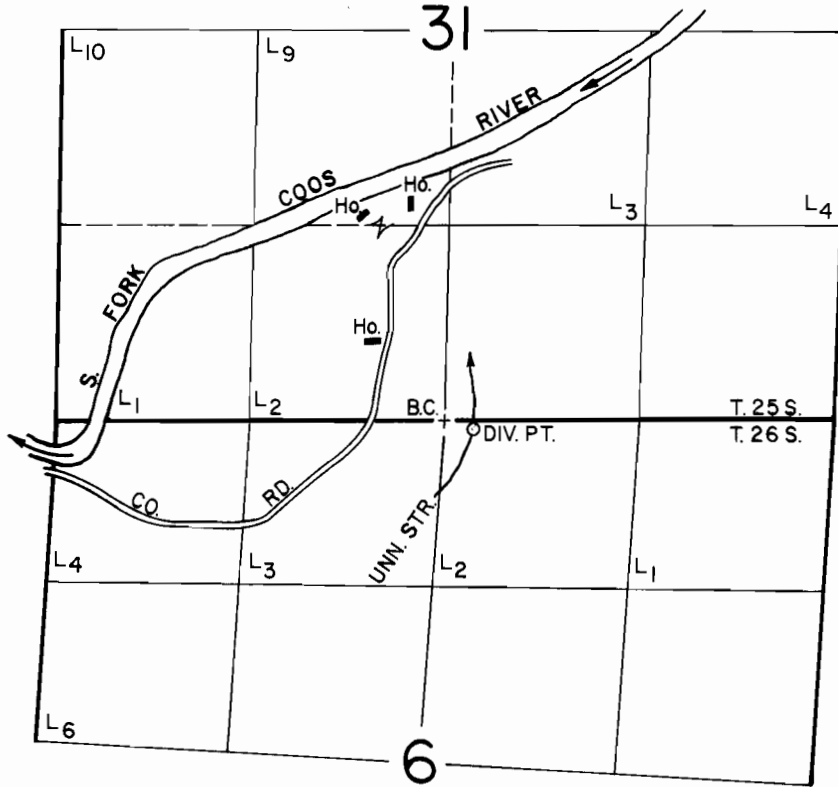

DIV.PT.LOC: 50'S. & 200'E. FROM N.1/4 CORNER SECTION 6

SCALE: 1" = 1320'

**FINAL PROOF SURVEY**  
UNDER

Application No. 68239 Permit No. 49227.....  
IN NAME OF

T. KENNETH SMITH & RALEIGH P. WIRTH

Surveyed SEPT. 21, 1988, by B. W. BISHOP.....