

SECTION 2 T.2S. R.1E. W.M.

CLACKAMAS COUNTY

D.L.C.
LOT WHITCOMB NO. 41
S. H. TRYONS NO. 42
JOSIAH FRANKLIN NO. 43
ALBERT DURHAM NO. 44
JOSEPH KELLOGG NO. 47
GEORGE CROW NO. 49

2 IE 2
& INDEX
LAKE OSWEGO


Application No. 68344
Permit No. 49485

RECEIVED

SEP 26 1985

WATER RESOURCES DEPT
SALEM, OREGON

COUNTY

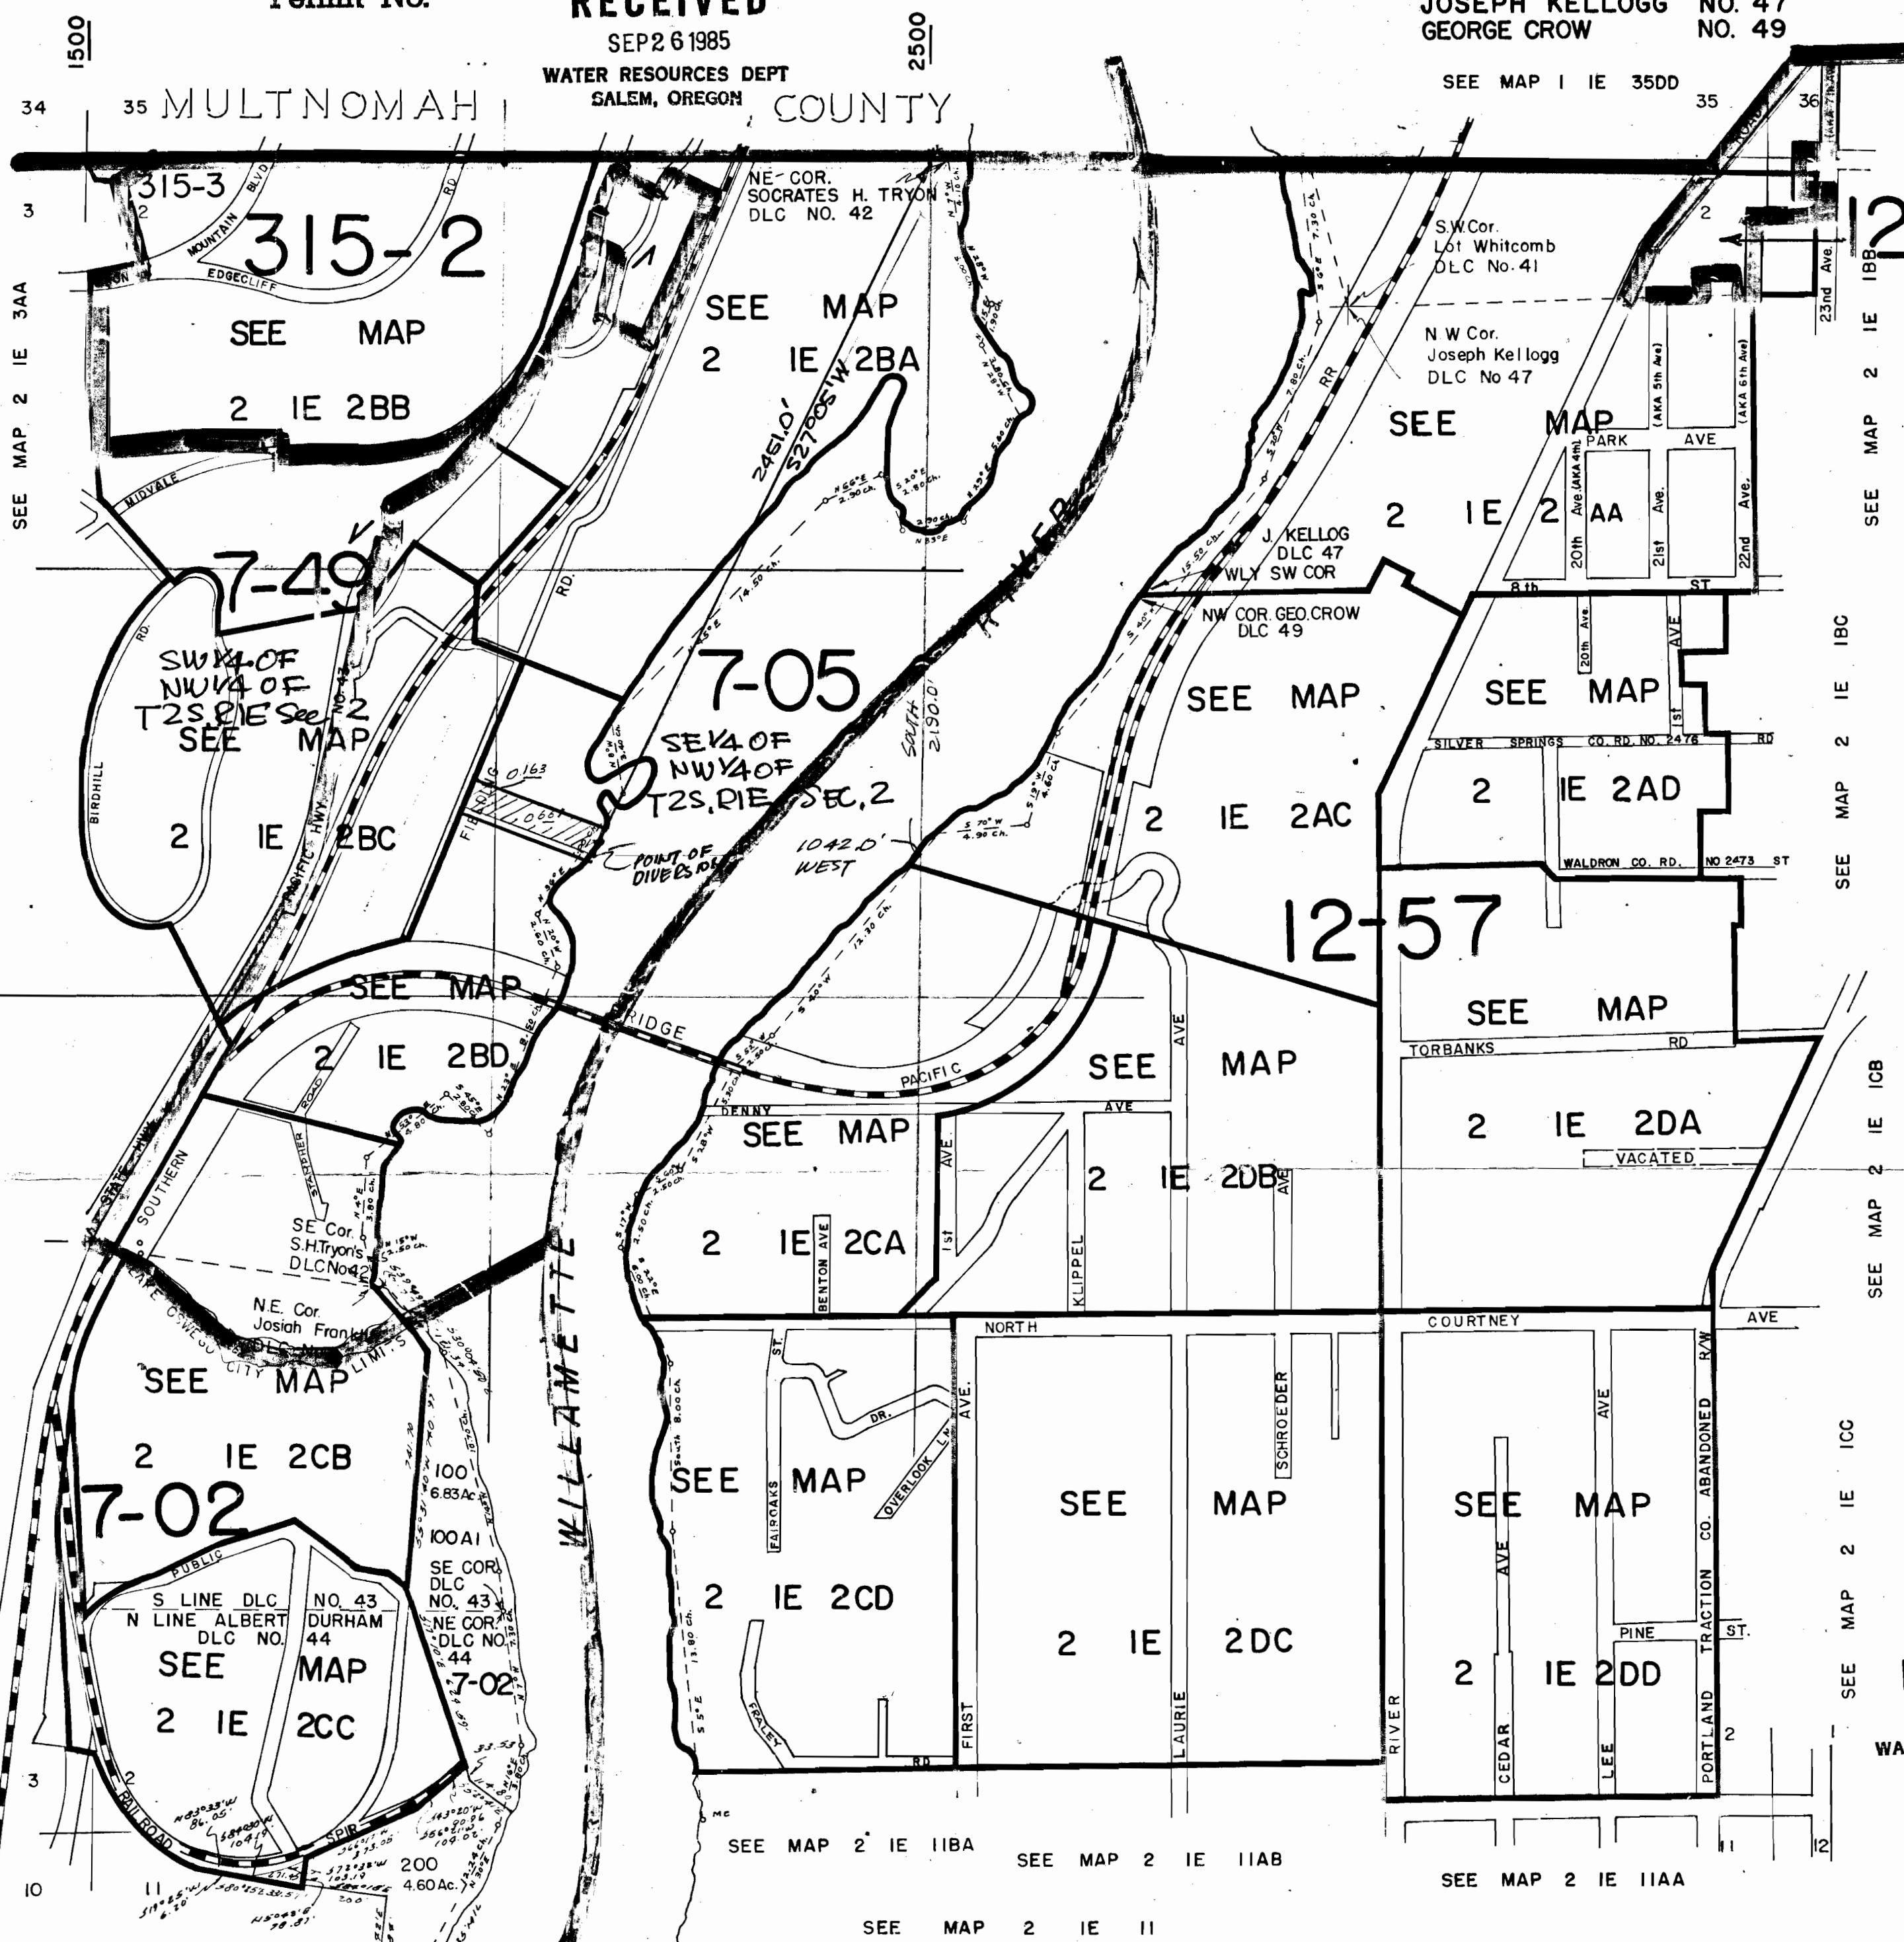

12-06

RECEIVED

JUL 24 1985

WATER RESOURCES DEPT
SALEM, OREGON

12-57

13500

RECEIVED

JUN 11 1985

WATER RESOURCES DEPT
SALEM, OREGON

14500

BOOK 7
2 IE 2
& INDEX

