




T. 25 S., R. 11 W., W.M.

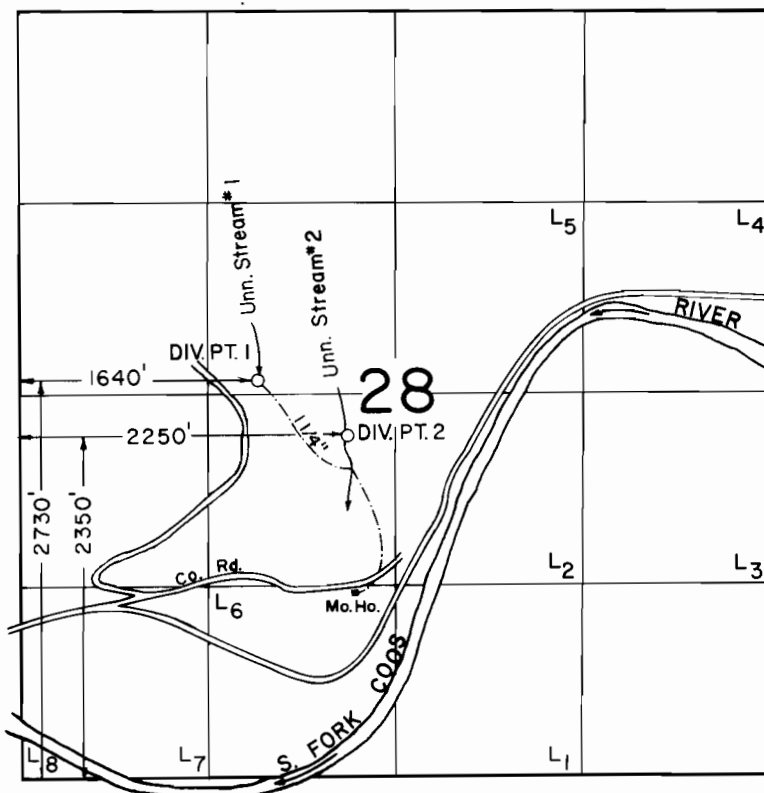

SCALE: 1" = 1320'

FINAL PROOF SURVEY
UNDER

Application No. 69048.. Permit No. 49987.....
IN NAME OF

.....**MARY L. LITTLE**.....

Surveyed SEPT. 18. 1988., by B. W. BISHOP.....