


# T.9S.R.I.W.W.M.

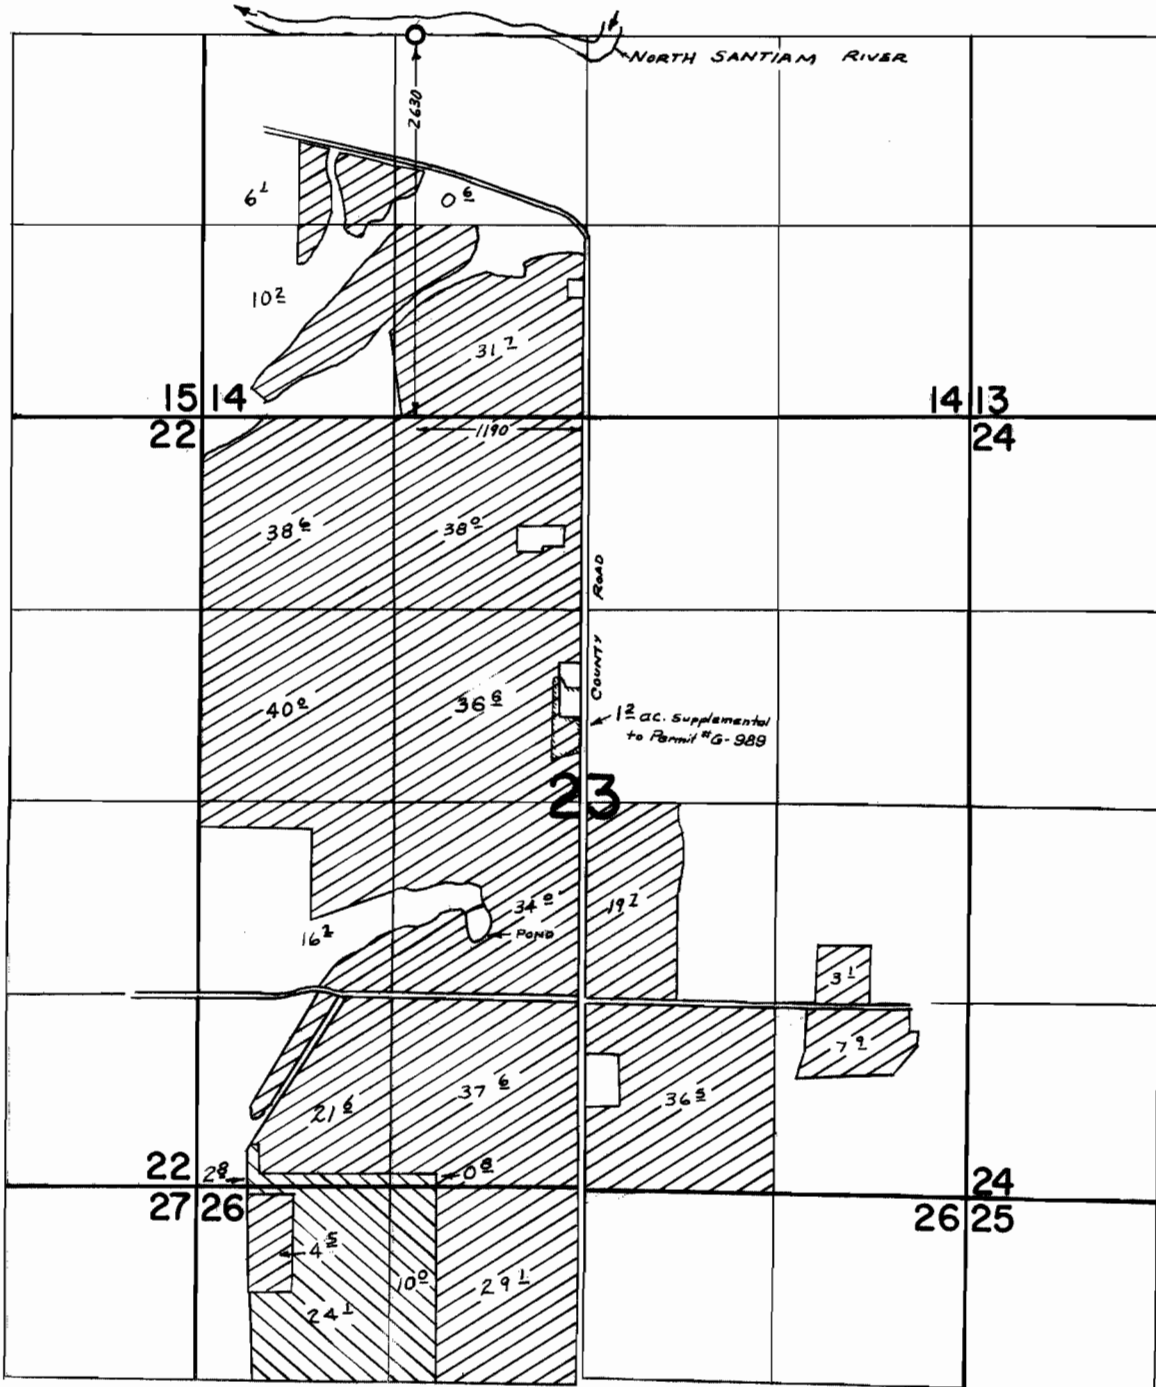

## FINAL PROOF SURVEY

Permit 32521  
Permit 26676



UNDER

Application No. <sup>33866</sup> 43480 Permit No. <sup>26676</sup> 32521  
IN NAME OF

**KINGSTON IRRIGATION COOPERATIVE**

Surveyed APR. 7, 1969, by W. RUPPERT.