


T. 9S. R. 1W. W.M.

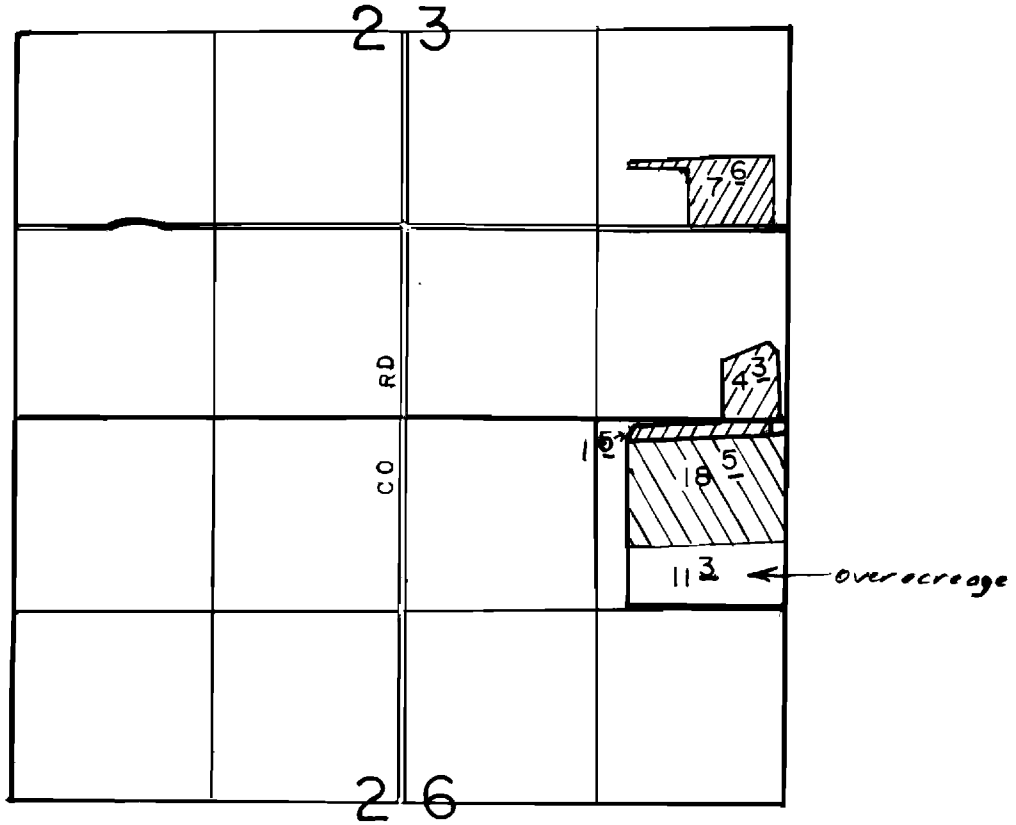

FINAL PROOF SURVEY

UNDER

T- 3569 

T- 3570 


Application No. Permit No.

IN NAME OF

CHARLES HECHT

Surveyed APRIL 26... 1984., by B.W. BISHOP.....

T.9S.R.I.W.W.M.

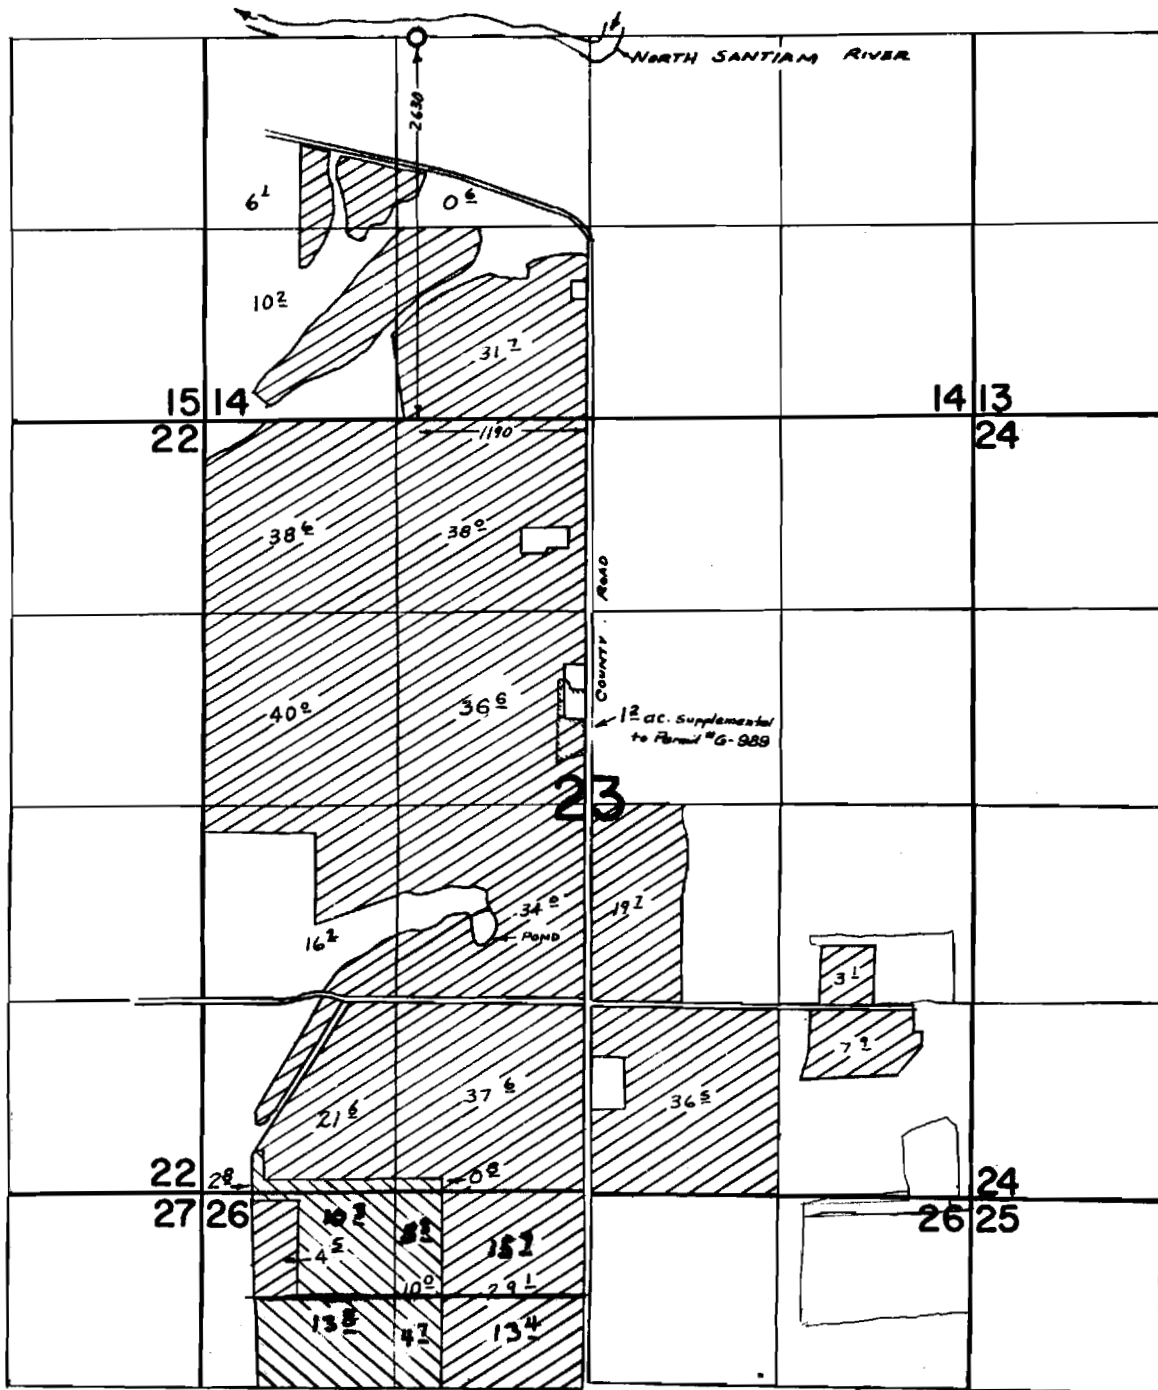

FINAL PROOF SURVEY

Permit 32521
Permit 26676



UNDER

Application No. ~~33866~~ 43480 Permit No. ~~26676~~ 32521
IN NAME OF

~~KINGSTON IRRIGATION COOPERATIVE~~

Surveyed ~~APR 7~~ 1969, by ~~W. RUPPERT~~

T #

"FROM"

T-3509 S.M. DEN-2A-72