


G-8780
60953

T. 26 S., R. 18 E., W. M.

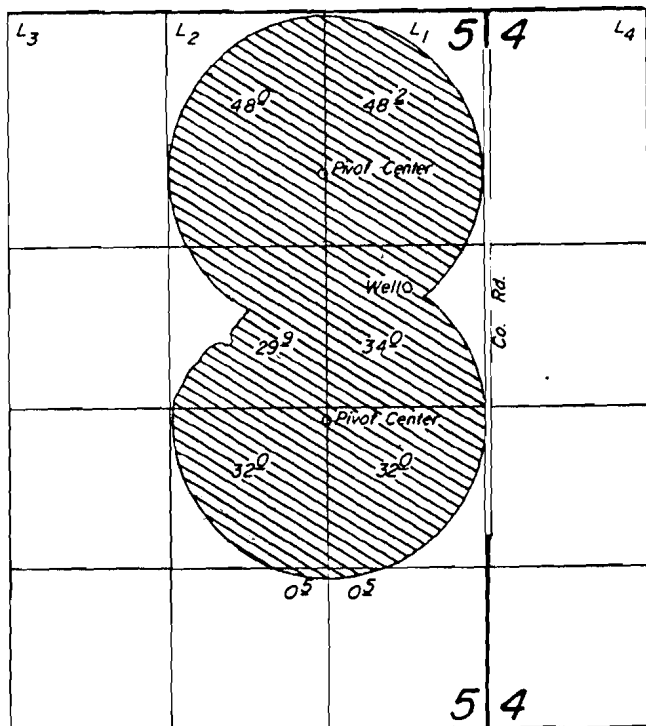

Well Loc.: 2290' S. & 650' W. from NE Cor. Sec. 5.

Scale: 1" = 1320'

FINAL PROOF SURVEY UNDER

Application No. G-2421. Permit No. G-8780...
IN NAME OF

Water Resources Dept.

Surveyed JULY 21, 1983, by L. TOLL.....
& OCTOBER 11, 1985, by B. Bishop

PTS-1983-2
PTS-1985-L
T.M.W.