


T. 15 S., R. 6 W., W. M.
SECTION 2

N

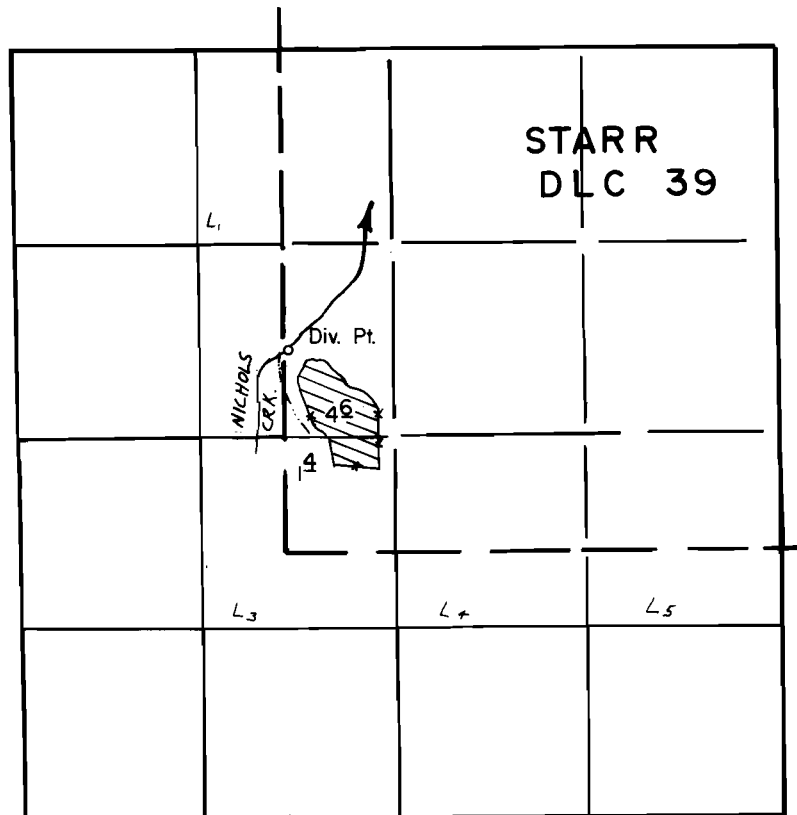

Div. Pt. Loc.: 1400' N. & 30' E. from SW Cor. DLC 39.

Scale : 1" = 1320'

FINAL PROOF SURVEY
UNDER

Application No. **56470** Permit No. **42764**.....
IN NAME OF

ANDREW J. SIMMONDS.....

Surveyed **JUNE 27 1983**, by **L. TOLL**.....