


T. 23S., R. 27E., W.M.

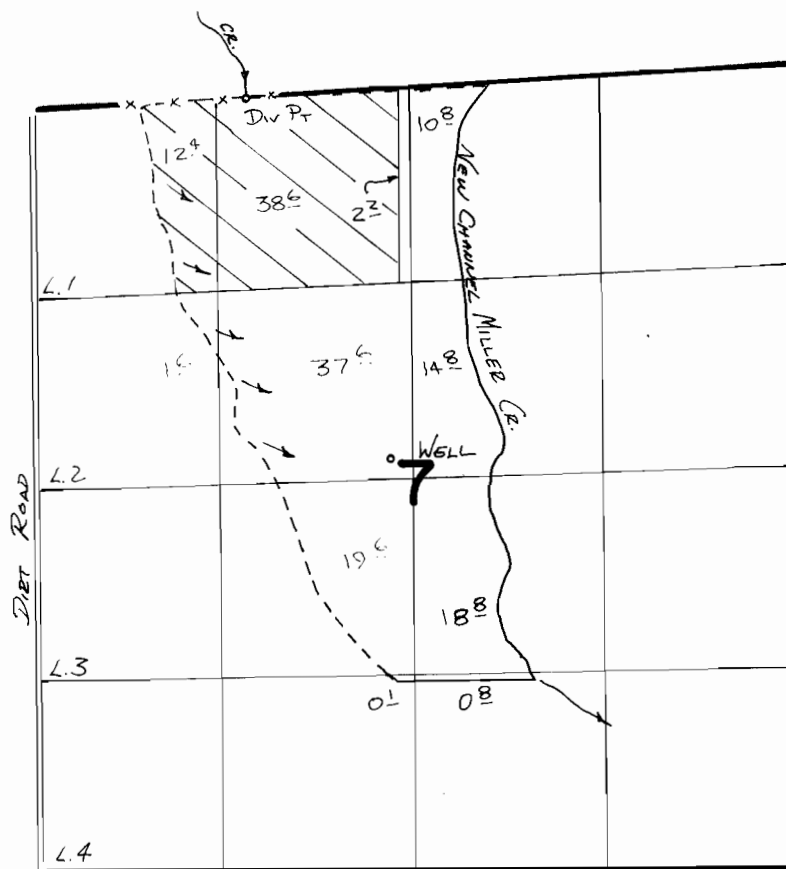

Div. Pt. Loc: 1450 E. FROM NW CORNER SEC 7

WELL Loc: 2820' N. & 2440' E. FROM SW COR. SEC. 7

FINAL PROOF SURVEY UNDER

Application No. **G-8642** **57249** Permit No. **G-8055** **43009**
IN NAME OF

MEADOW CREEK ENTERPRISES

Surveyed 5-6 1988, by B.W. Bishop