


T.2N.,R.2W.,W.M.

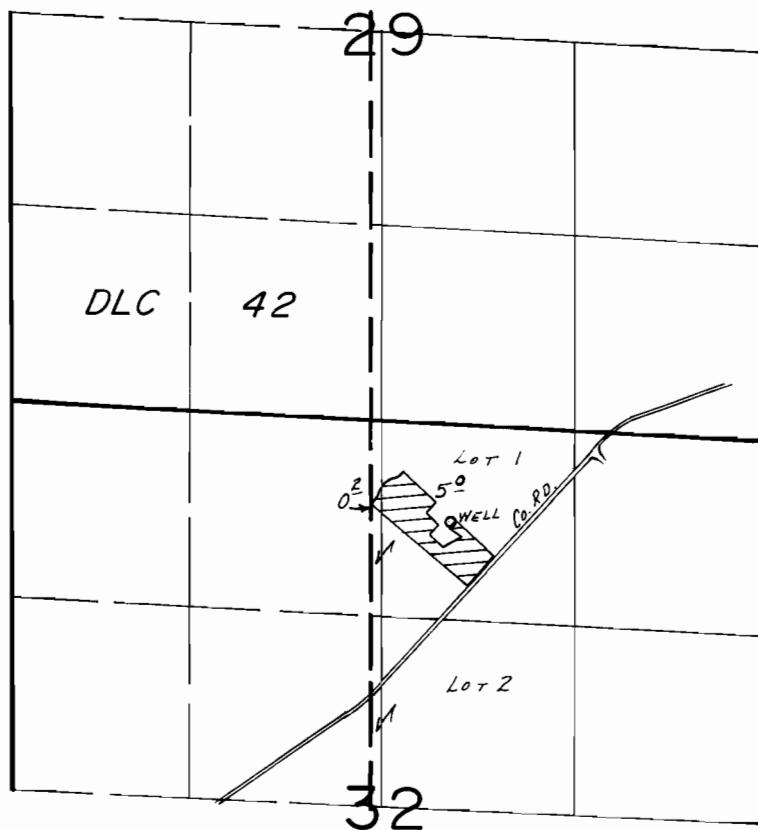

WELL LOC.: 550 S. & 2180 W. FROM NE COR. SEC. 32.

SCALE: 1"=1320'

FINAL PROOF SURVEY UNDER

Application No. G-9341... Permit No. G-8795....
IN NAME OF

.....JANICE F. GIBERT.....

Surveyed Sept. 27... 1984, by B.W. BISHOP.....