


T. 36 S., R. 2 W., W. M.

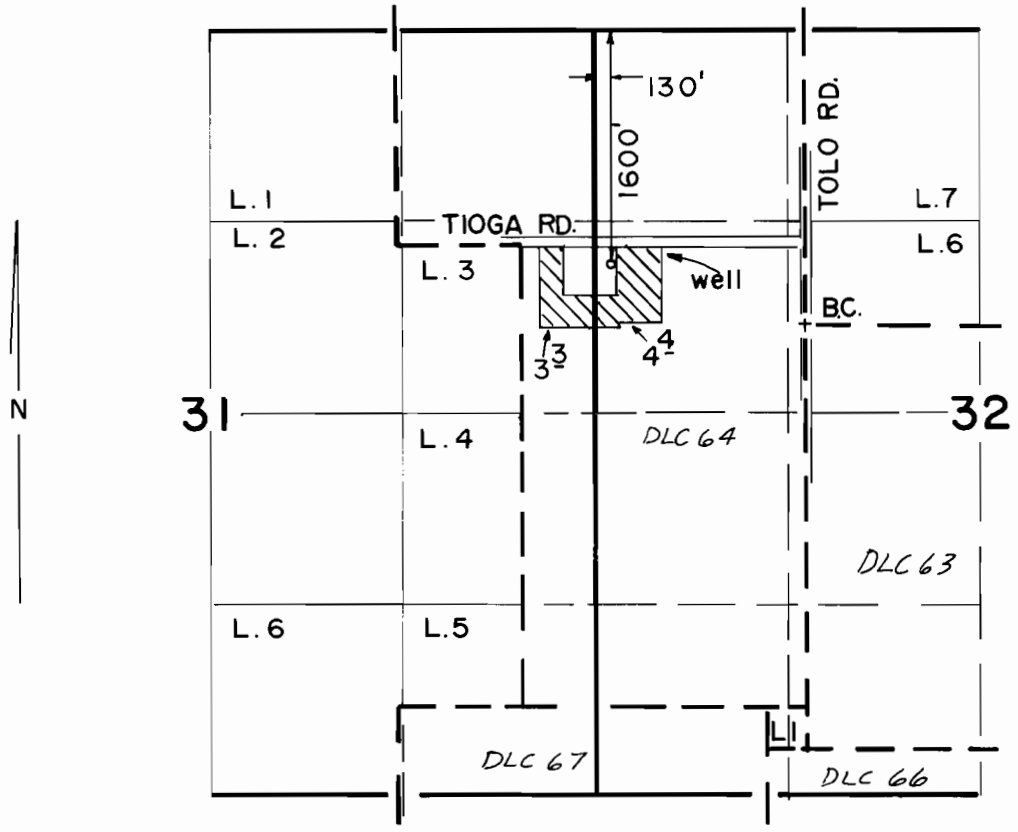

Scale: 1" = 1320'

FINAL PROOF SURVEY UNDER

Application No. G-9342 Permit No. G-8783
IN NAME OF

ROBERT L. SIMPSON

Surveyed MAY. 28. 19.86, by B. S. JAMES