


8766
60966

T. 6N., R. 35E., W.M.

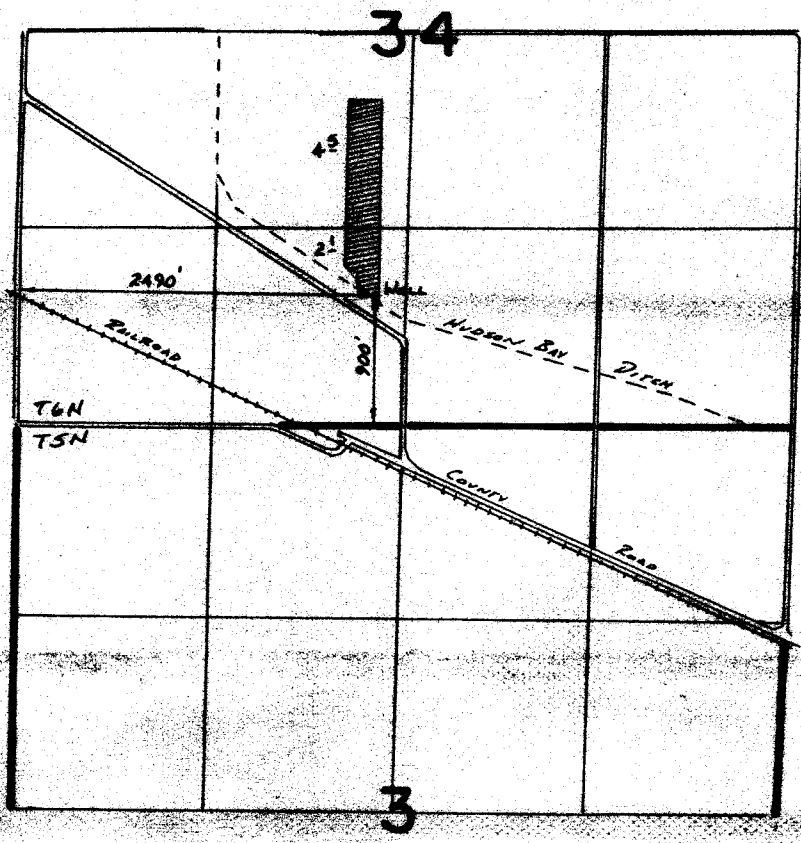

FINAL PROOF SURVEY
UNDER

Application No. G:9404 Permit No. G:8766...
IN NAME OF

.....BERT.....PESCIALLO.....

Surveyed June 22, 1983, by V.L. Church.....