
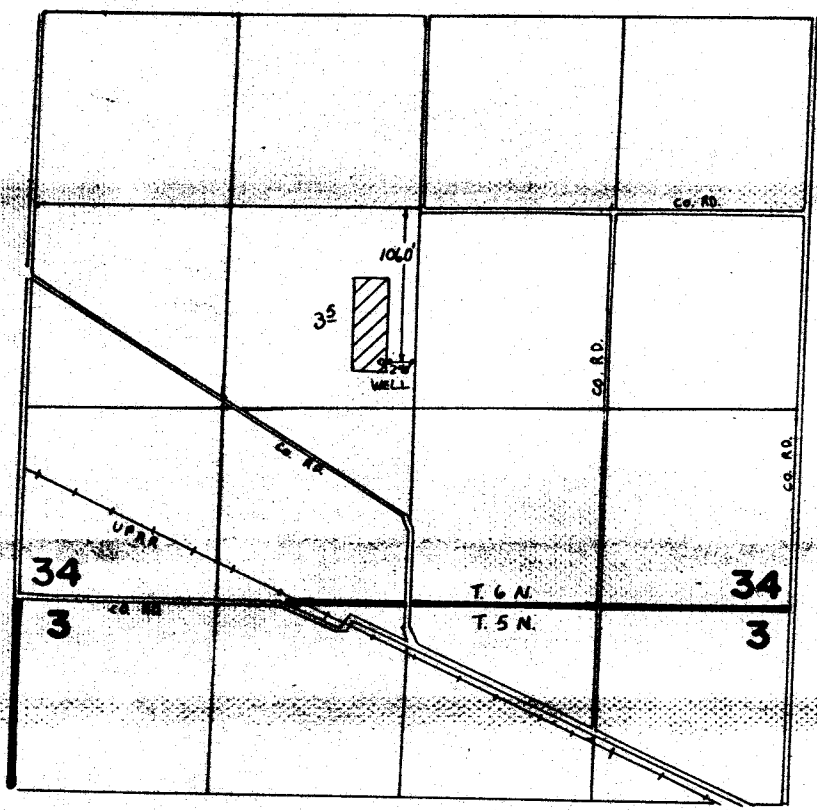


810184
60967

T. 5 & 6 N. R. 35 E. W.M.

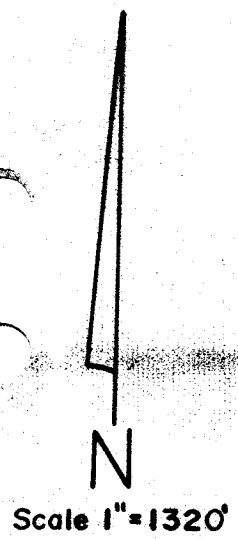

FINAL PROOF SURVEY UNDER

Application No. G.11019.. Permit No. G.10184.....
IN NAME OF

.....**BERT PESCIALLO**.....

Surveyed March. 2.. 1987., by V. Church.....