


910185

60966

# T. 6 N. R. 35 E. W.M.



Scale 1" = 1320'

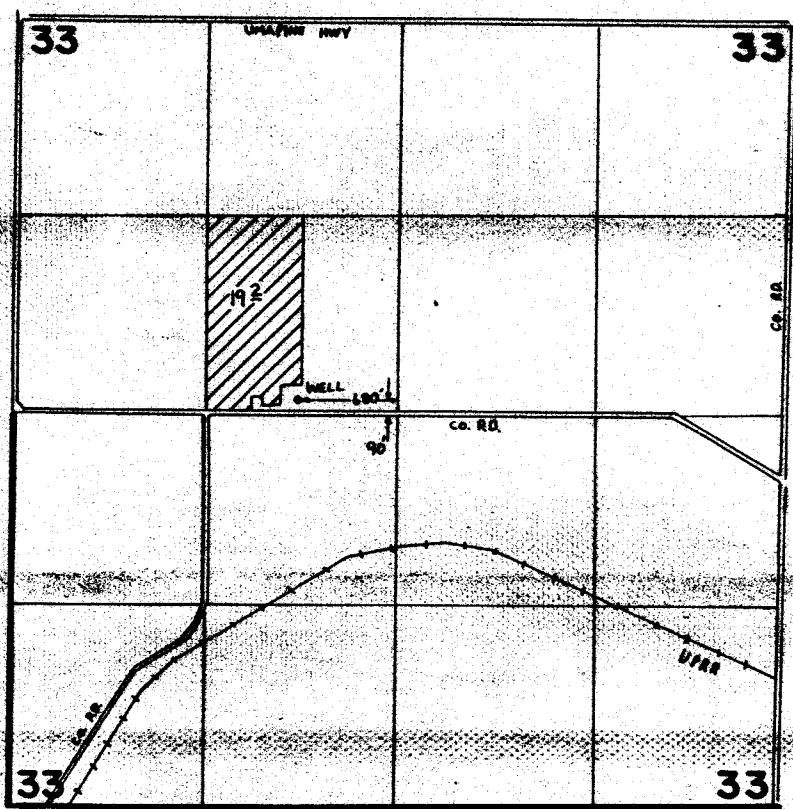

## FINAL PROOF SURVEY UNDER

Application No. G11020 Permit No. G10185.....  
IN NAME OF

.....**BERT PESCIALLO**.....

Surveyed March. 2.. 1987., by V. Church.....