


T.7S., R.2 W., W.M.

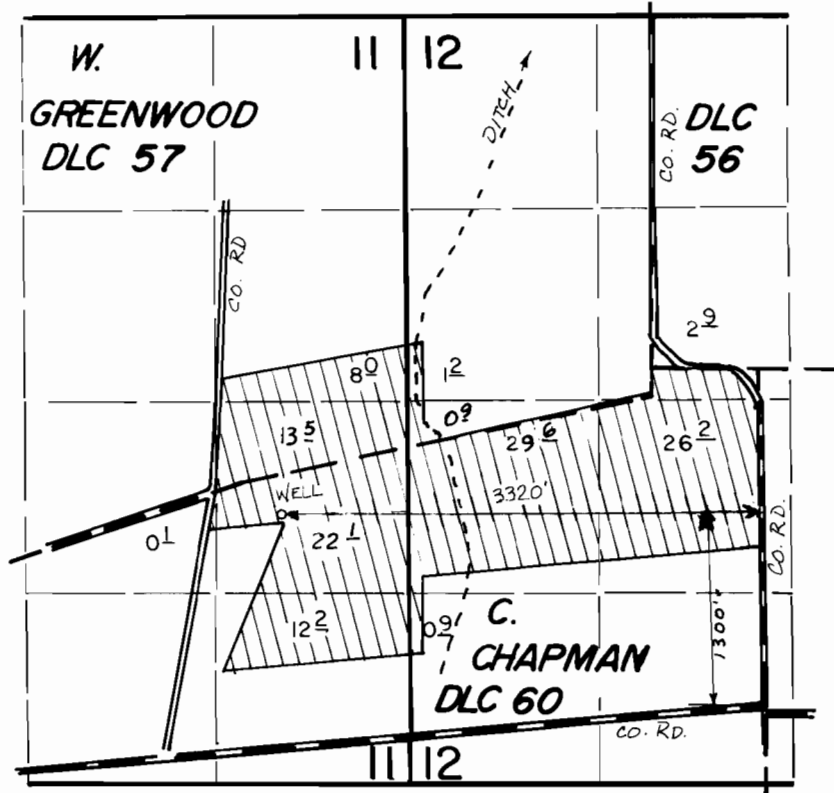

FINAL PROOF SURVEY UNDER

Application No. G-9715 Permit No. G-9040
IN NAME OF

CECIL ROTH

Surveyed NOV. 17, 1983, by M. CAHILL