


# T.6S.,R.1E.,W.M.

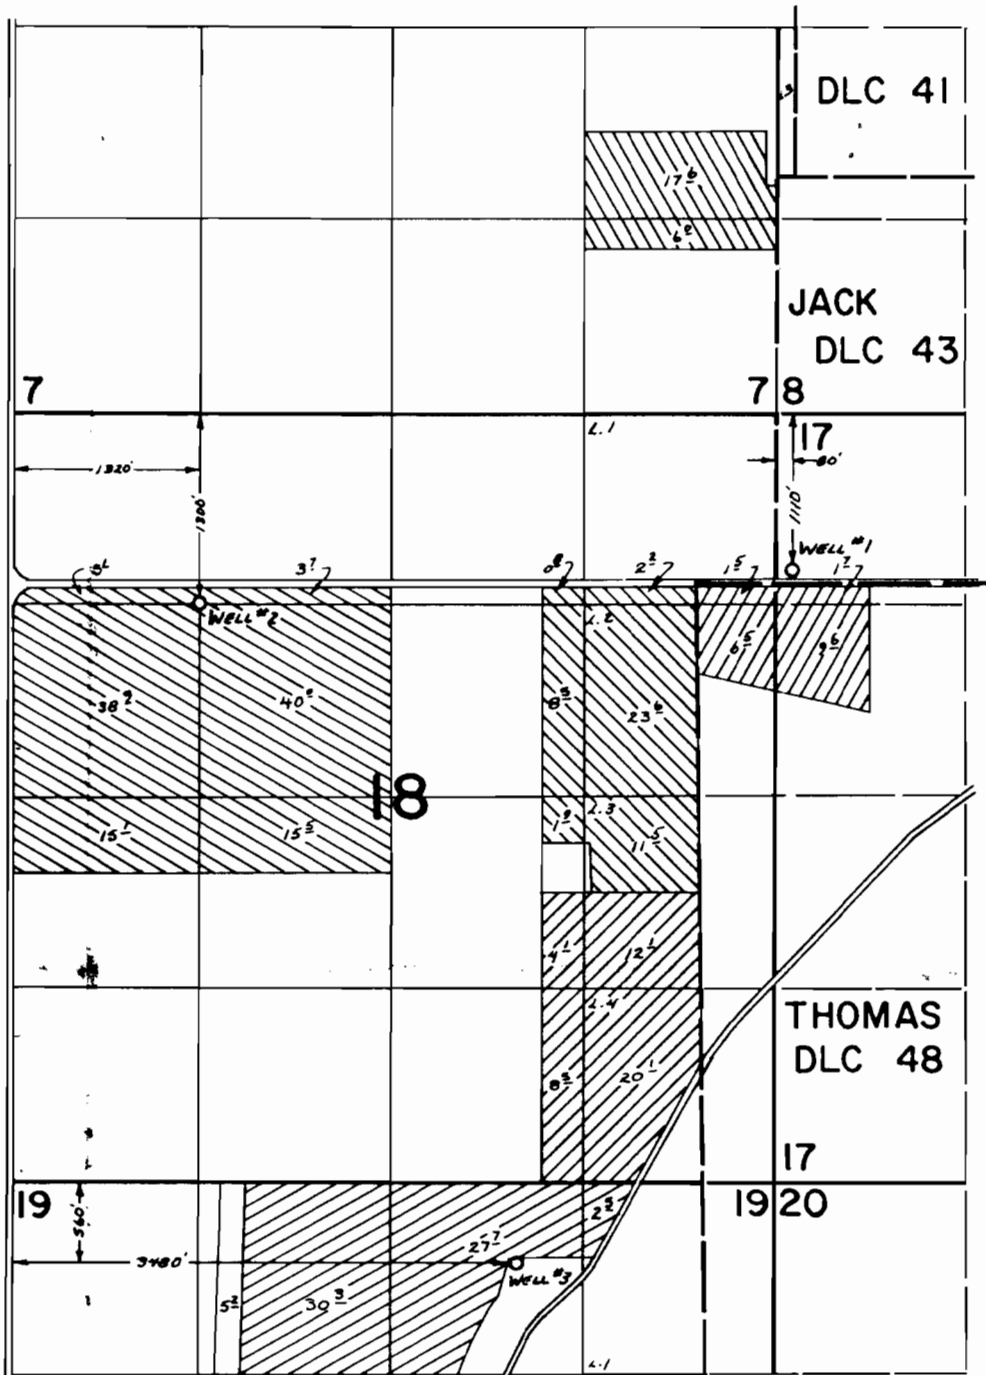

## FINAL PROOF SURVEY

UNDER

G-8146

G-9728

G-9729

G-7584

G-8952

G-8953

Application No. G-9730 Permit No. G-9180

IN NAME OF

**HAROLD KRAEMER**

Surveyed Sept. 9, 1981, by S. C. BROWN

