


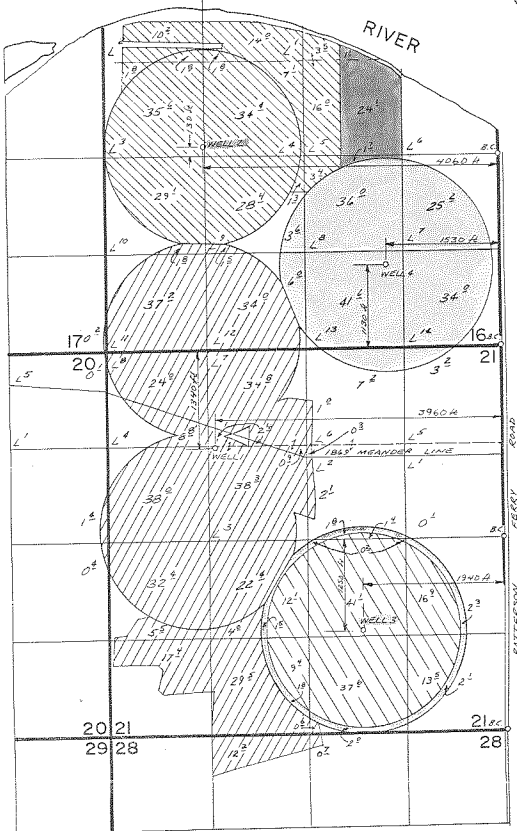

T.5N.,R.26E.,W.M.

RECEIVED
SEPO 91980
WATER RESOURCES DEPT
SALEM, OREGON

COLUMBIA

RIVER



-  - IRRIGATED FROM WELL #4
-  - IRRIGATED FROM WELL #3
-  - IRRIGATED FROM WELL #2