


T. 9S., R. 4W., W.M.

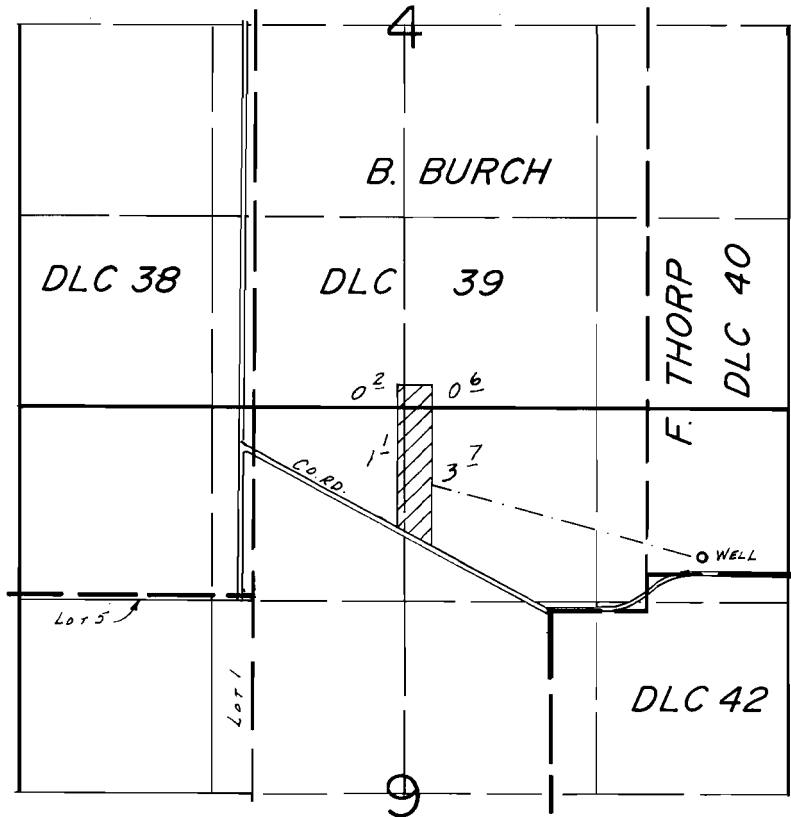

WELL LOC.: 110' N. & 380' E. FROM SW COR. F. THORP DLC 40.

SCALE: 1" = 1320'

### FINAL PROOF SURVEY UNDER

Application No. G:9910. Permit No. G:9046....  
IN NAME OF

MARIAN WARREN

Surveyed Sept. 4.... 1984, by P.R. PAGTER.....

2/10/87  
BWB