
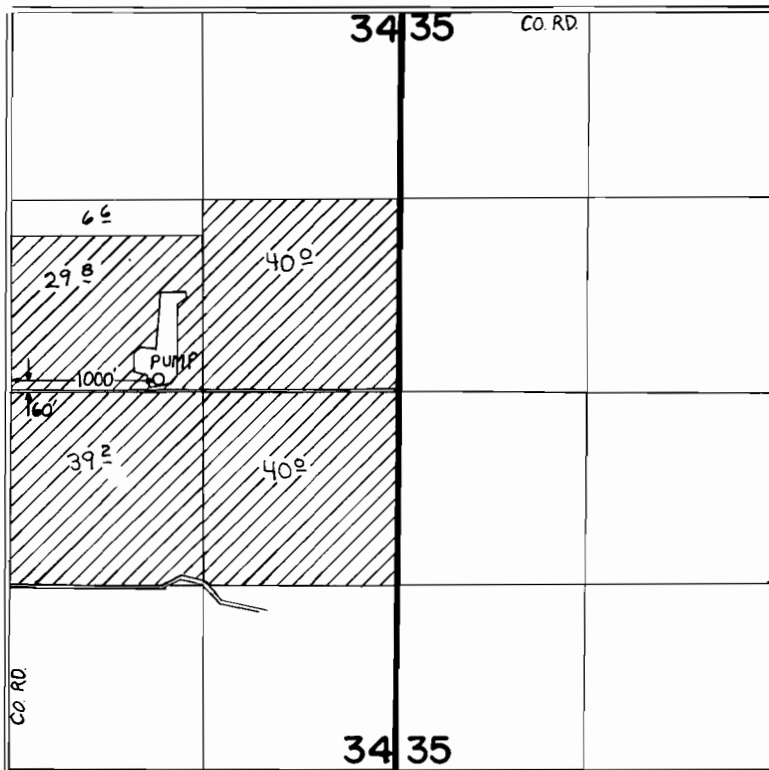


# T. 8 S., R. 40 E., W.M.

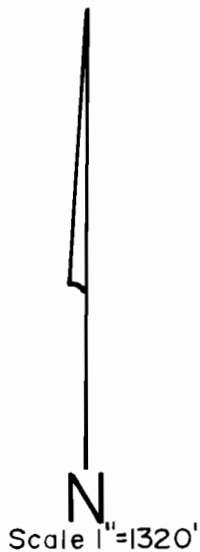

## FINAL PROOF SURVEY

UNDER

Application No. G.9953. Permit No. G.9012.....  
IN NAME OF

**J. W. HEATON**

Surveyed June 5..... 1986, by V. Church.....