


T.12S. R.5W. W.M.

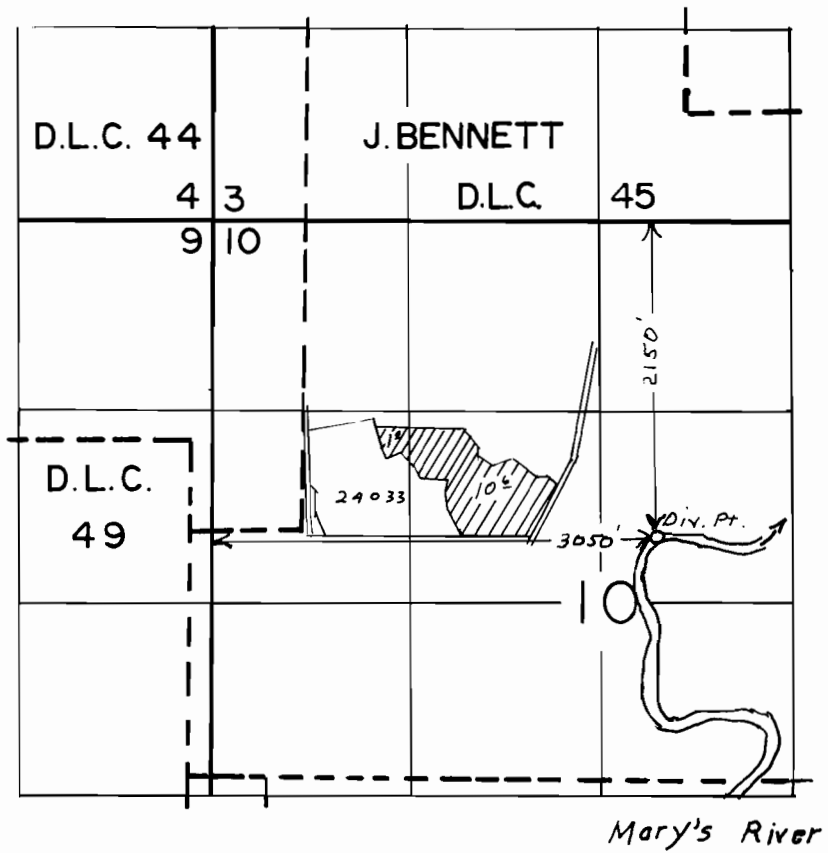

SCALE: 1" = 1320'

**FINAL PROOF SURVEY**  
UNDER

Application No. 38557... Permit No. 2919.7....  
IN NAME OF

BENTON MEMORIAL PARK ASSOCIATION.

Surveyed NOV. 17. 1987., by T.M. WARREN.....