


T. 3S., R. 40E., W. M.

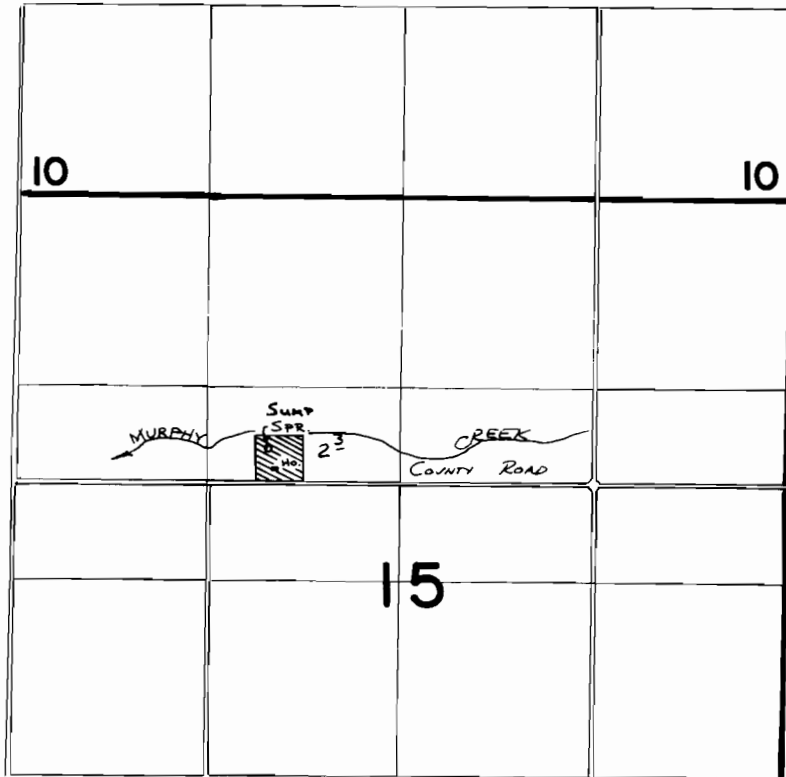

Scale: 1" = 1320'

Div. Pt. Loc: 1730'S. & 900'W. FROM N<sup>1</sup>/<sub>4</sub> COR. SEC. 15

**FINAL PROOF SURVEY**  
UNDER

Application No. **50201** Permit No. **37757**.....  
IN NAME OF

.....**DAVE & CAMI VENABLE**.....

Surveyed ..1..28..... 1988., by *V.L. Church*.....