


T.11S., R.4 W., W.M.

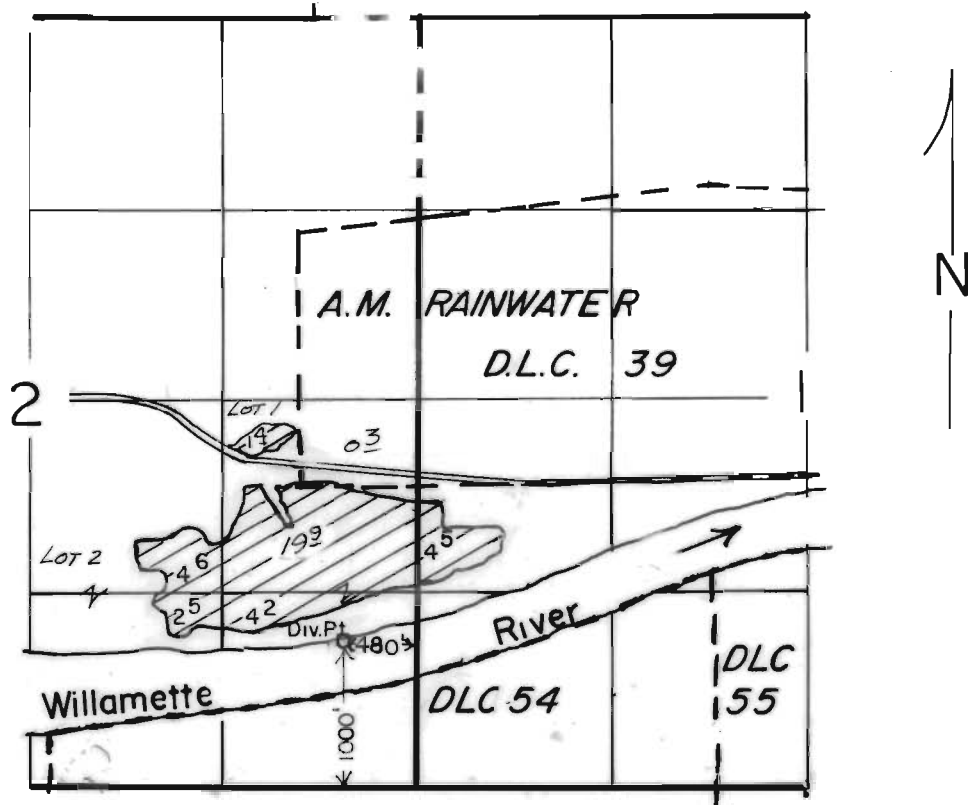

SCALE: 1" = 1320'

FINAL PROOF SURVEY
UNDER

Application No. 51.7.4.6... Permit No. .39.000....
IN NAME OF

.....J.J. LOONEY..... ESTATE.....

Surveyed APRIL 29 1987., by T.M. WARREN.....