


# T. 41 S., R. 12 W., W.M.

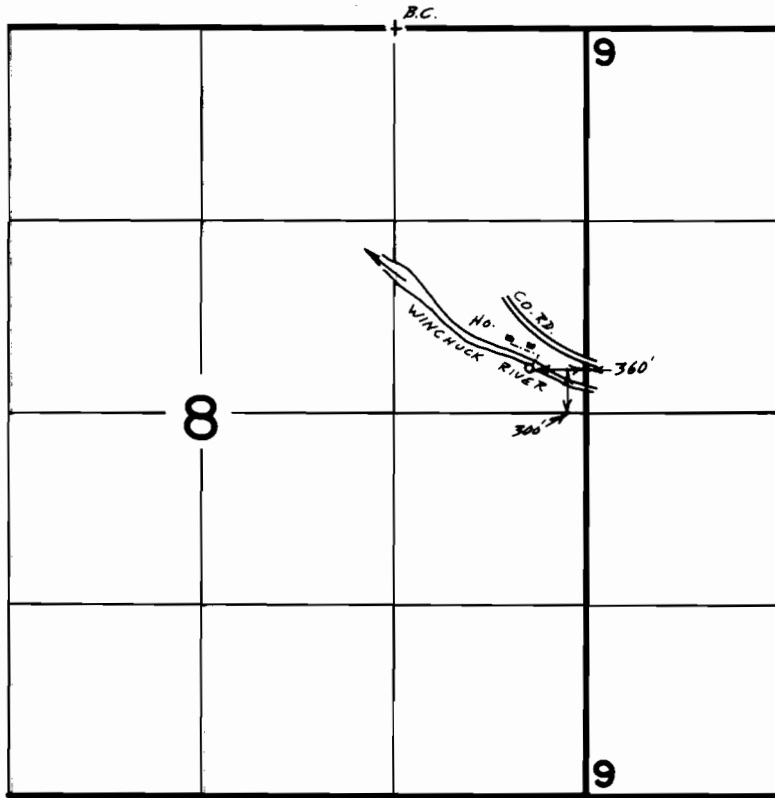

Scale 1" = 1320'

## FINAL PROOF SURVEY UNDER

Application No. 52084. Permit No. 37744....  
IN NAME OF

.....ROBERT L. BOWLIN.....

Surveyed Nov. 7, 1988, by B.S. JAMES.....