


T 1S., R. 43E., W.M.

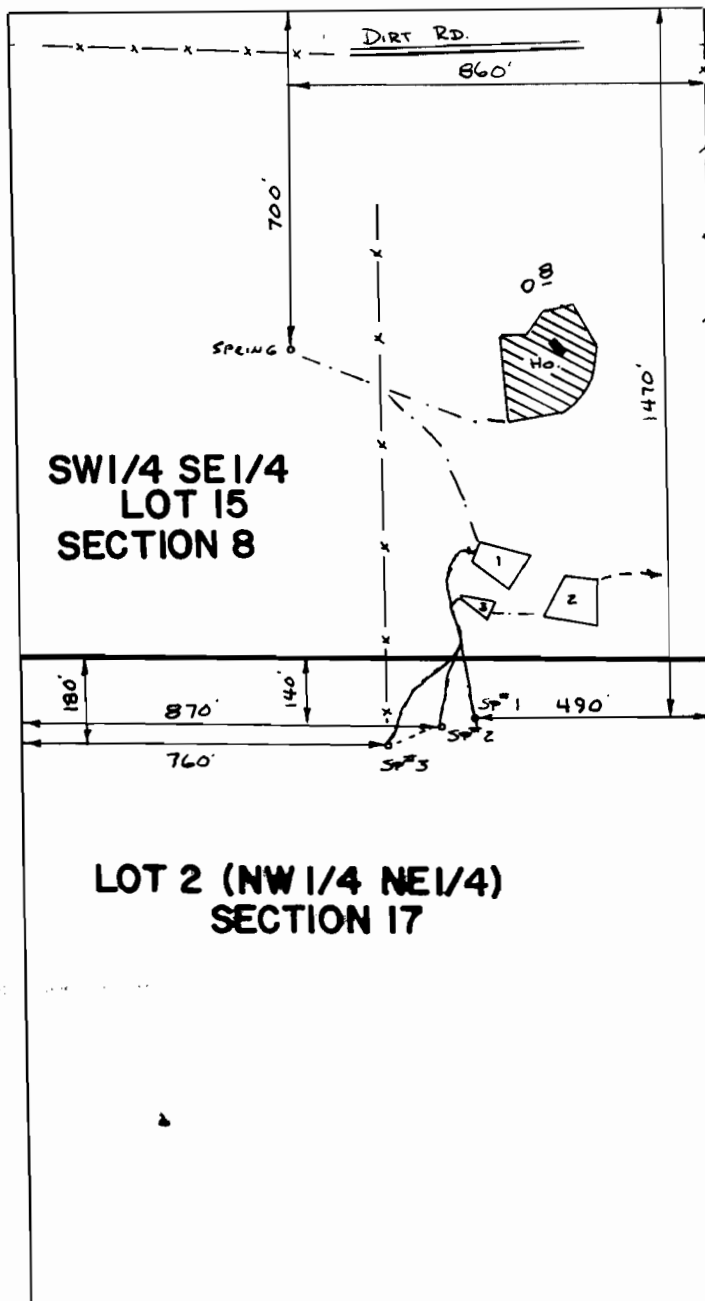

SCALE 1" = 1320'

FINAL PROOF SURVEY
UNDER

R-52825 R-6322
Application No. **52681** Permit No. **39461**
IN NAME OF

LARRY A. MILLER

Surveyed **8-8** 1988, by