


T2S. R1E. W1M.

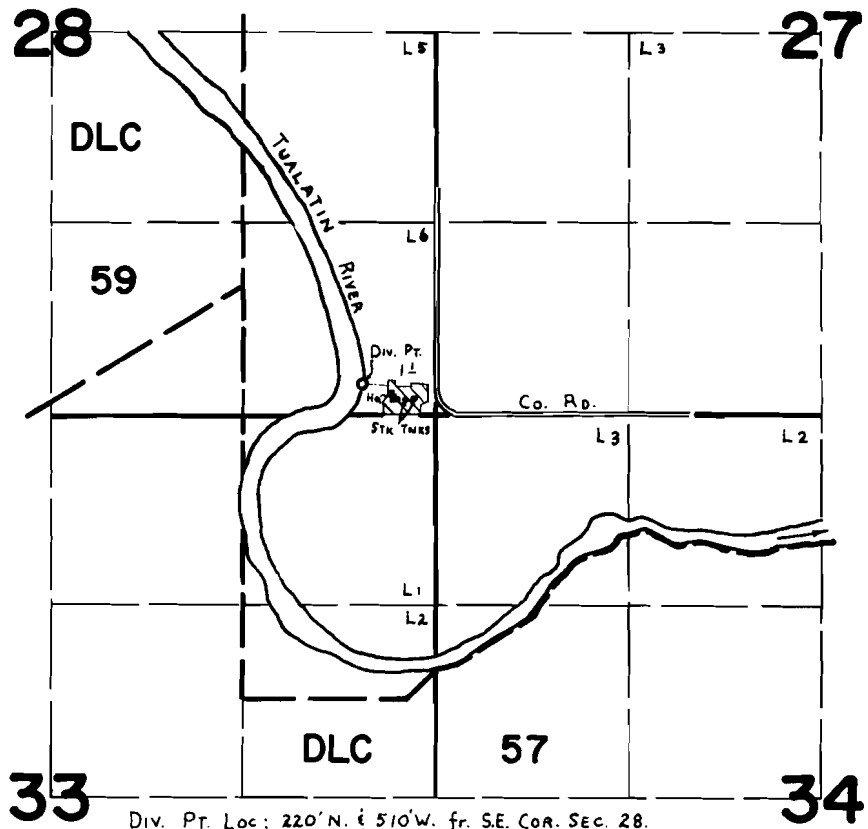

FINAL PROOF SURVEY UNDER

Application No. 54093 Permit No. 40607
IN NAME OF

ELEANOR R. PHINNEY

Surveyed OCT. 16, 1978, by C. L. HUGHES