


T. 6S.R. 1W.W.M.

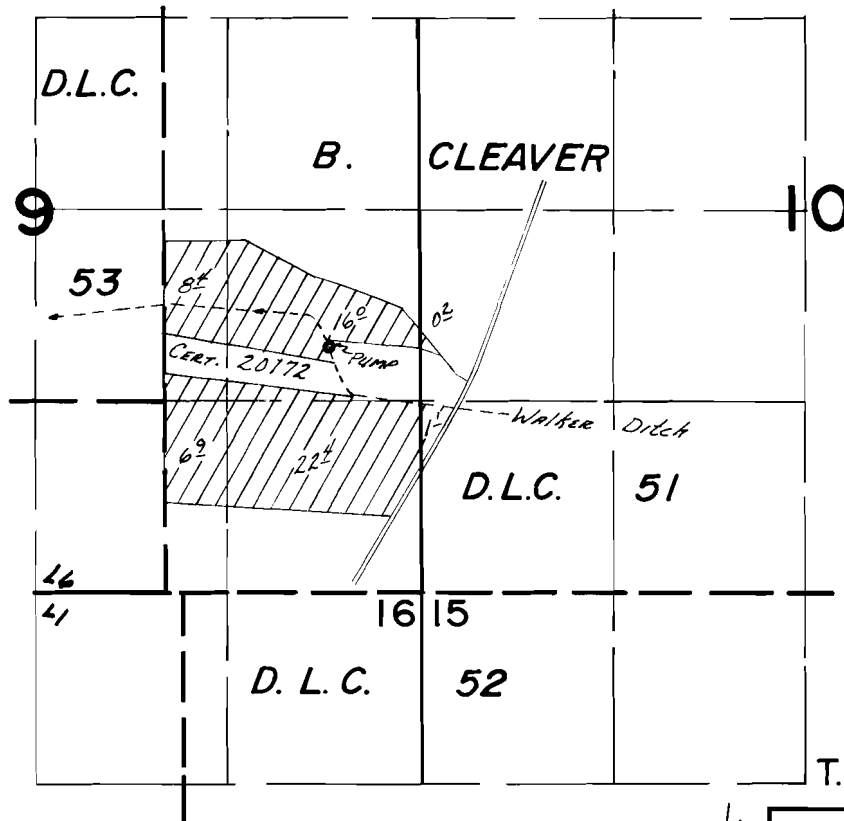


T. 6 S., R. 1 W., W.M.

FINAL PROOF SURVEY UNDER

Application No. 55661... Permit No. 41696...
IN NAME OF

BENEDICTINE SISTERS

Surveyed Oct. 4, 1979, by C.R. RODRIGUEZ

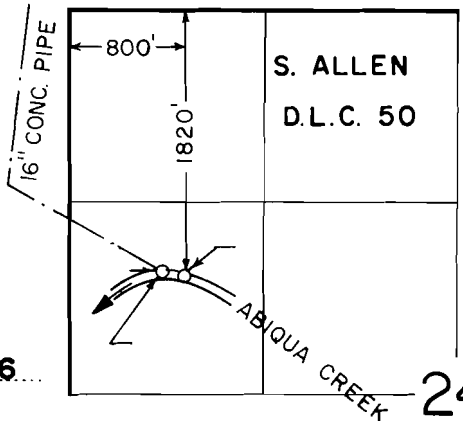

24