


**T2S, R5E, WM
SEC 31**

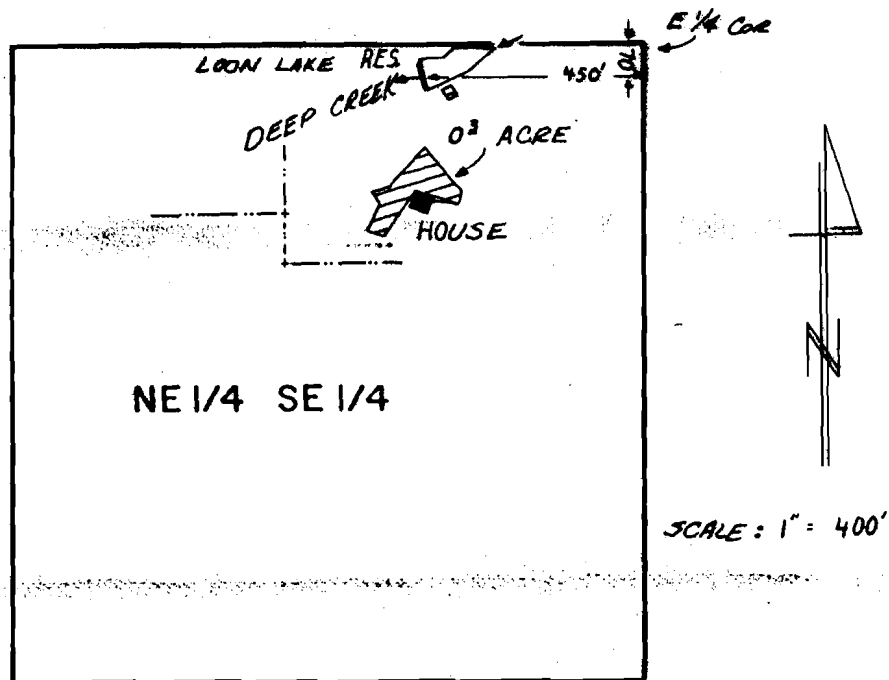

**FINAL PROOF SURVEY
UNDER**

R-55793 R-6729
Application No. ~~55793~~ Permit No. ~~42466~~...
IN NAME OF

.....DUANE KEITH BRIDGE.....

Surveyed AUG. 4... 1987., by J. M. WARREN...