


**T2S, R5E, WM
SEC 31**

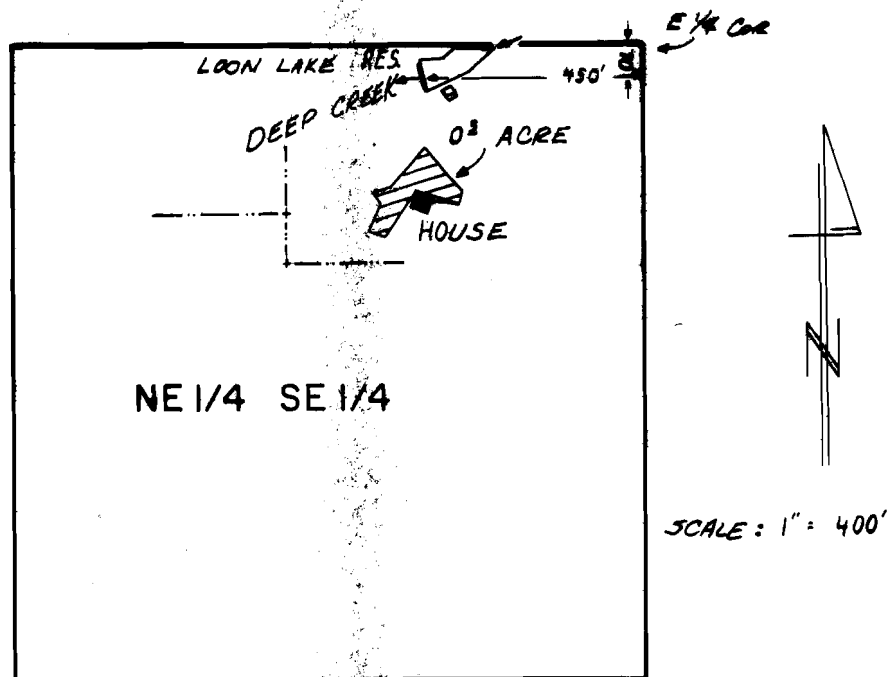

**FINAL PROOF SURVEY
UNDER**

R-55793 R-6729
Application No. 55793 Permit No. 42466...
IN NAME OF

.....DUANE KEITH BRIDGE.....

Surveyed AUG. 4, 1987, by T.M. WARREN...