


T. 7S., R. 5W., W.M.

SECTION 32

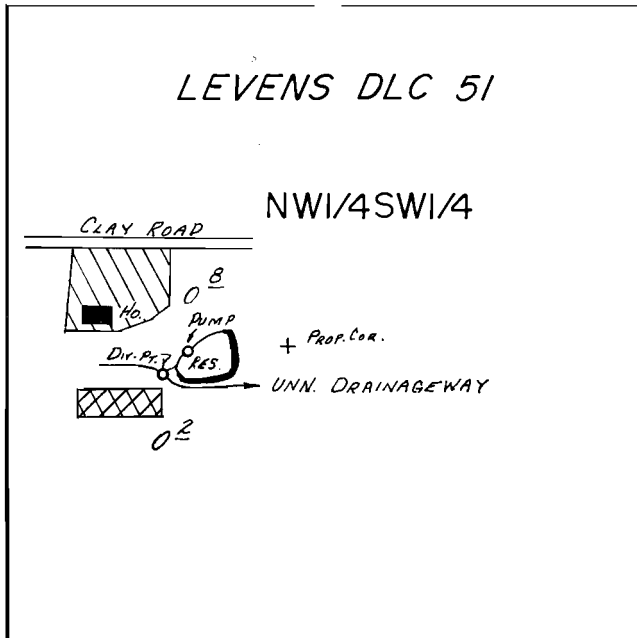

Div. Pt. Loc.: 770 S. & 320 E. FROM N 1/4 COR. SEC. 32

SCALE: 1" = 400'

FINAL PROOF SURVEY

UNDER



PRIMARY



SUPPLEMENTAL

R-55899

R-6738

Application No. 55900 Permit No. 42505.....

IN NAME OF

.....HERMAN VANWELL.....

Surveyed Aug. 10, 1983, by L.M. TOLL.....