


# T. 7S., R. 5W., W.M.

## SECTION 32

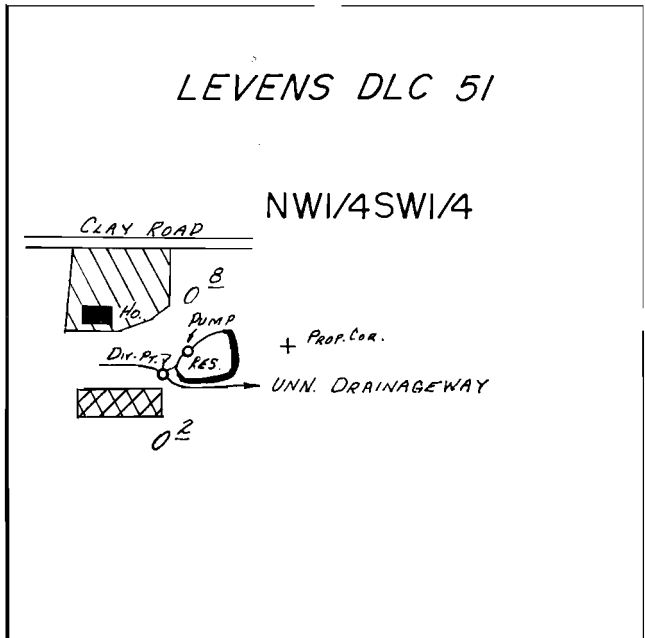

*Div. Pt. Loc.: 770'S. & 320'E. FROM N 1/4 COR. SEC. 32*

SCALE: 1" = 400'

### FINAL PROOF SURVEY

UNDER



PRIMARY



SUPPLEMENTAL

R-55899

R-6738

Application No. 55900 Permit No. 42505.....

IN NAME OF

.....HERMAN VANWELL.....

Surveyed Aug. 10... 1983, by L.M. TOLL.....