


T. 4S. R. 4E. W.M.

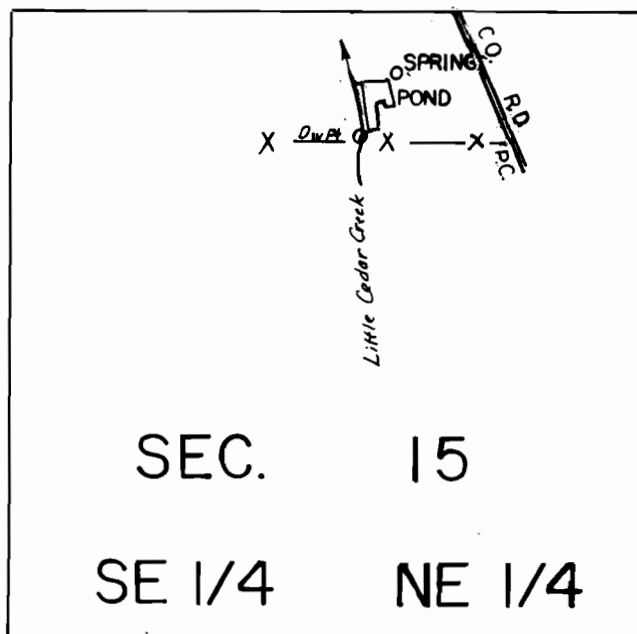

DIV. PT. LOC. 240' S. & 600' W., SPRING LOC. 130' S. & 530' W.
 BOTH FROM THE NE. COR. OF THE SE 1/4 OF THE NE. 1/4

SCALE: 1" = 400'

FINAL PROOF SURVEY UNDER

R-56064 R-6626
 Application No. **56065** Permit No. **41950**
 IN NAME OF

MICHAEL W. TALBERT

Surveyed JUNE 19... 1987... by T.M. WARREN