


T. 7S., R. 45E., W.M.

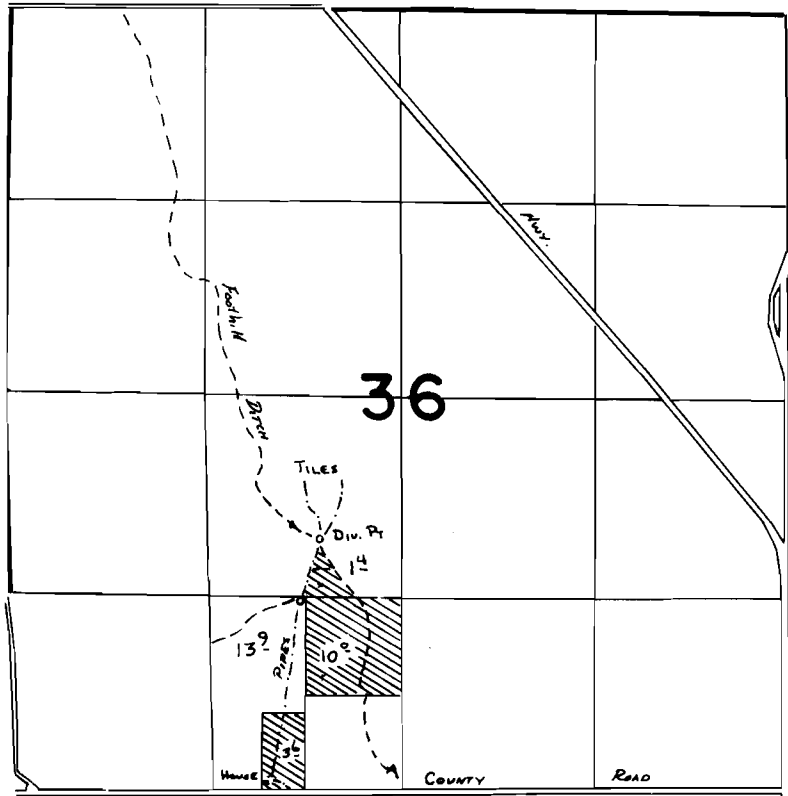

Div. Pt. Loc: 970 S. & 560 W. FROM CENTER COR. SEC 36
Stock Use from ditch.

FINAL PROOF SURVEY
UNDER

SCALE: 1" = 1320'

Application No. **56408**. Permit No. **42338**...
IN NAME OF

.....**MERLE HOGG**.....

Surveyed Aug. 1, 1984, by V.L.C. Church.....