


T.15S., R.10E., W.M.

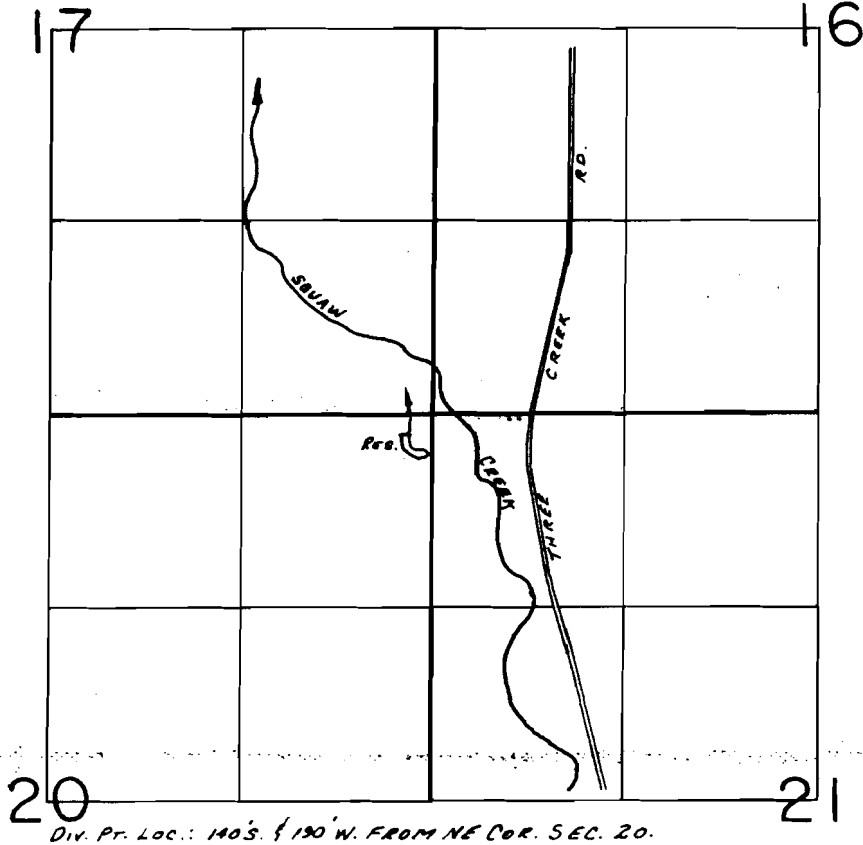

SCALE: 1" = 1320'

### FINAL PROOF SURVEY UNDER

R-57160                      R-7253    Cert. # 61003  
 Application No. ...57161... Permit No. ...43043...    Cert. # 61002 (recreation)  
 IN NAME OF

.....DON C. FRISBEE.....

Surveyed June 23, 1988, by B.W. BISHOP.....

RECEIVED

DATE 5-23-89

WATER MASTER DISTRICT #11

BY SMJ

11-21-88 AWB  
41013-279-225L

43043