


# T2S, R1E, WM SEC 36

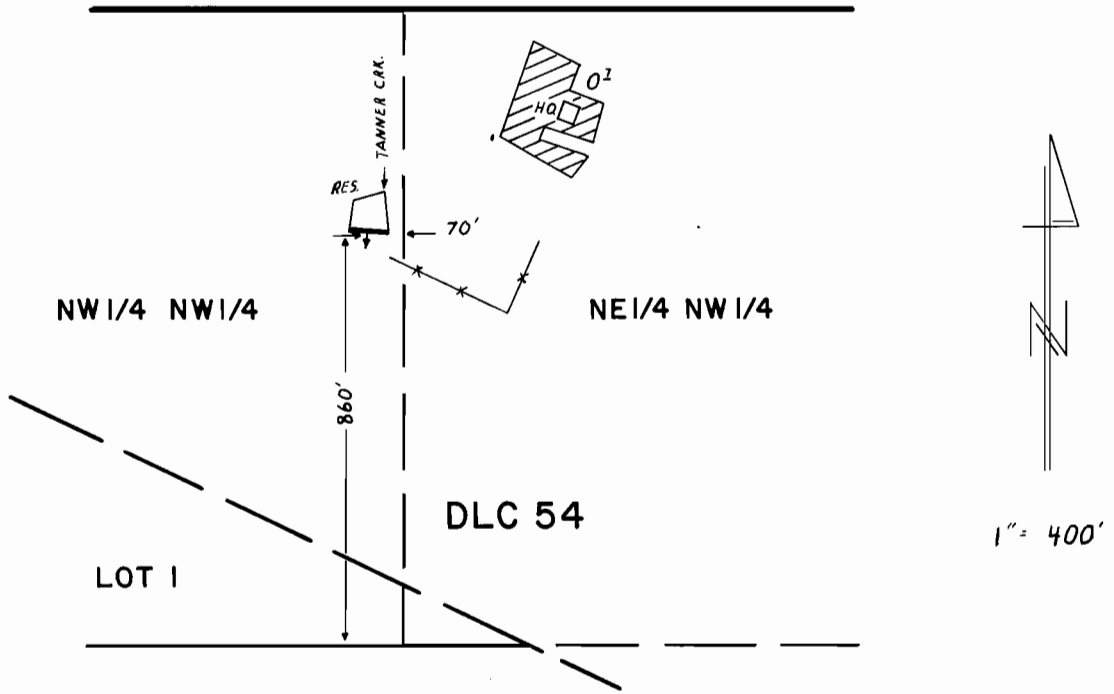

## FINAL PROOF SURVEY UNDER

R-57395                      R-7600  
 Application No. 57396 Permit No. 43248  
 IN NAME OF

EUGENE K. DAVIS

Surveyed JUNE 4 1987, by T.M. WARREN