


T2S, R1E, WM SEC 36

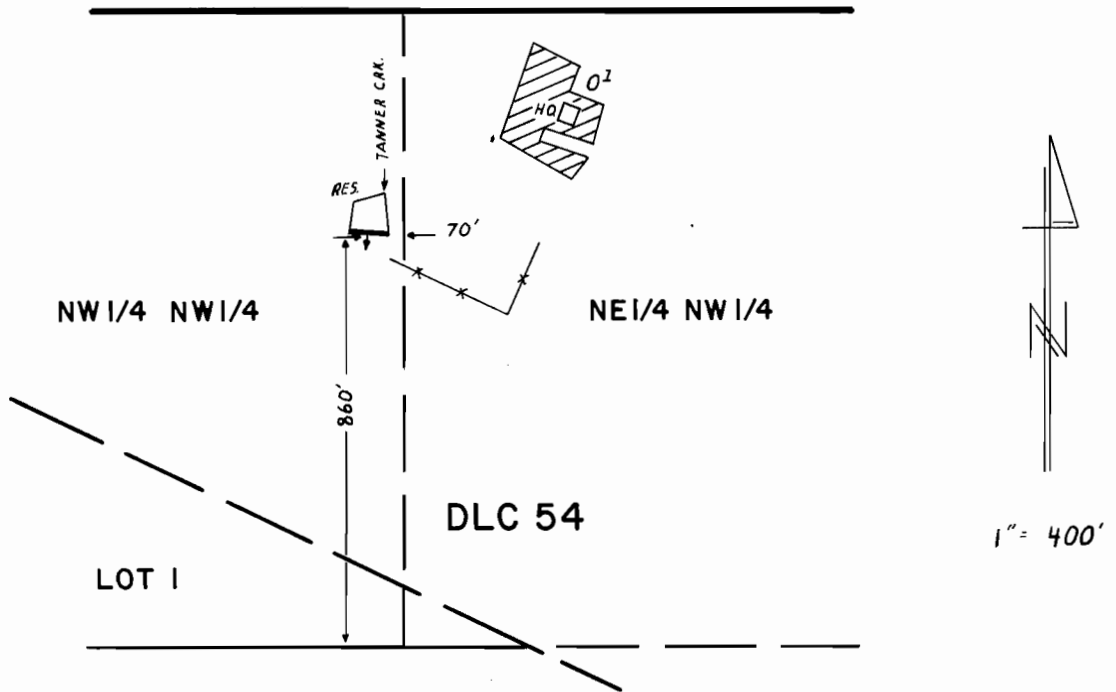

FINAL PROOF SURVEY UNDER

R-57395 R-7600
 Application No. 57396 Permit No. 43248
 IN NAME OF

..... EUGENE K. DAVIS

Surveyed JUNE 4 1987, by T.M. WARREN...